

Form AI-187
March 1961

UNITED STATES
DEPARTMENT OF THE INTERIOR
BUREAU OF LAND MANAGEMENT

SECTION


24

Oregon State Water Filings

0-6-407

TOWNSHIP 10S, RANGE 42E, W. M.

North

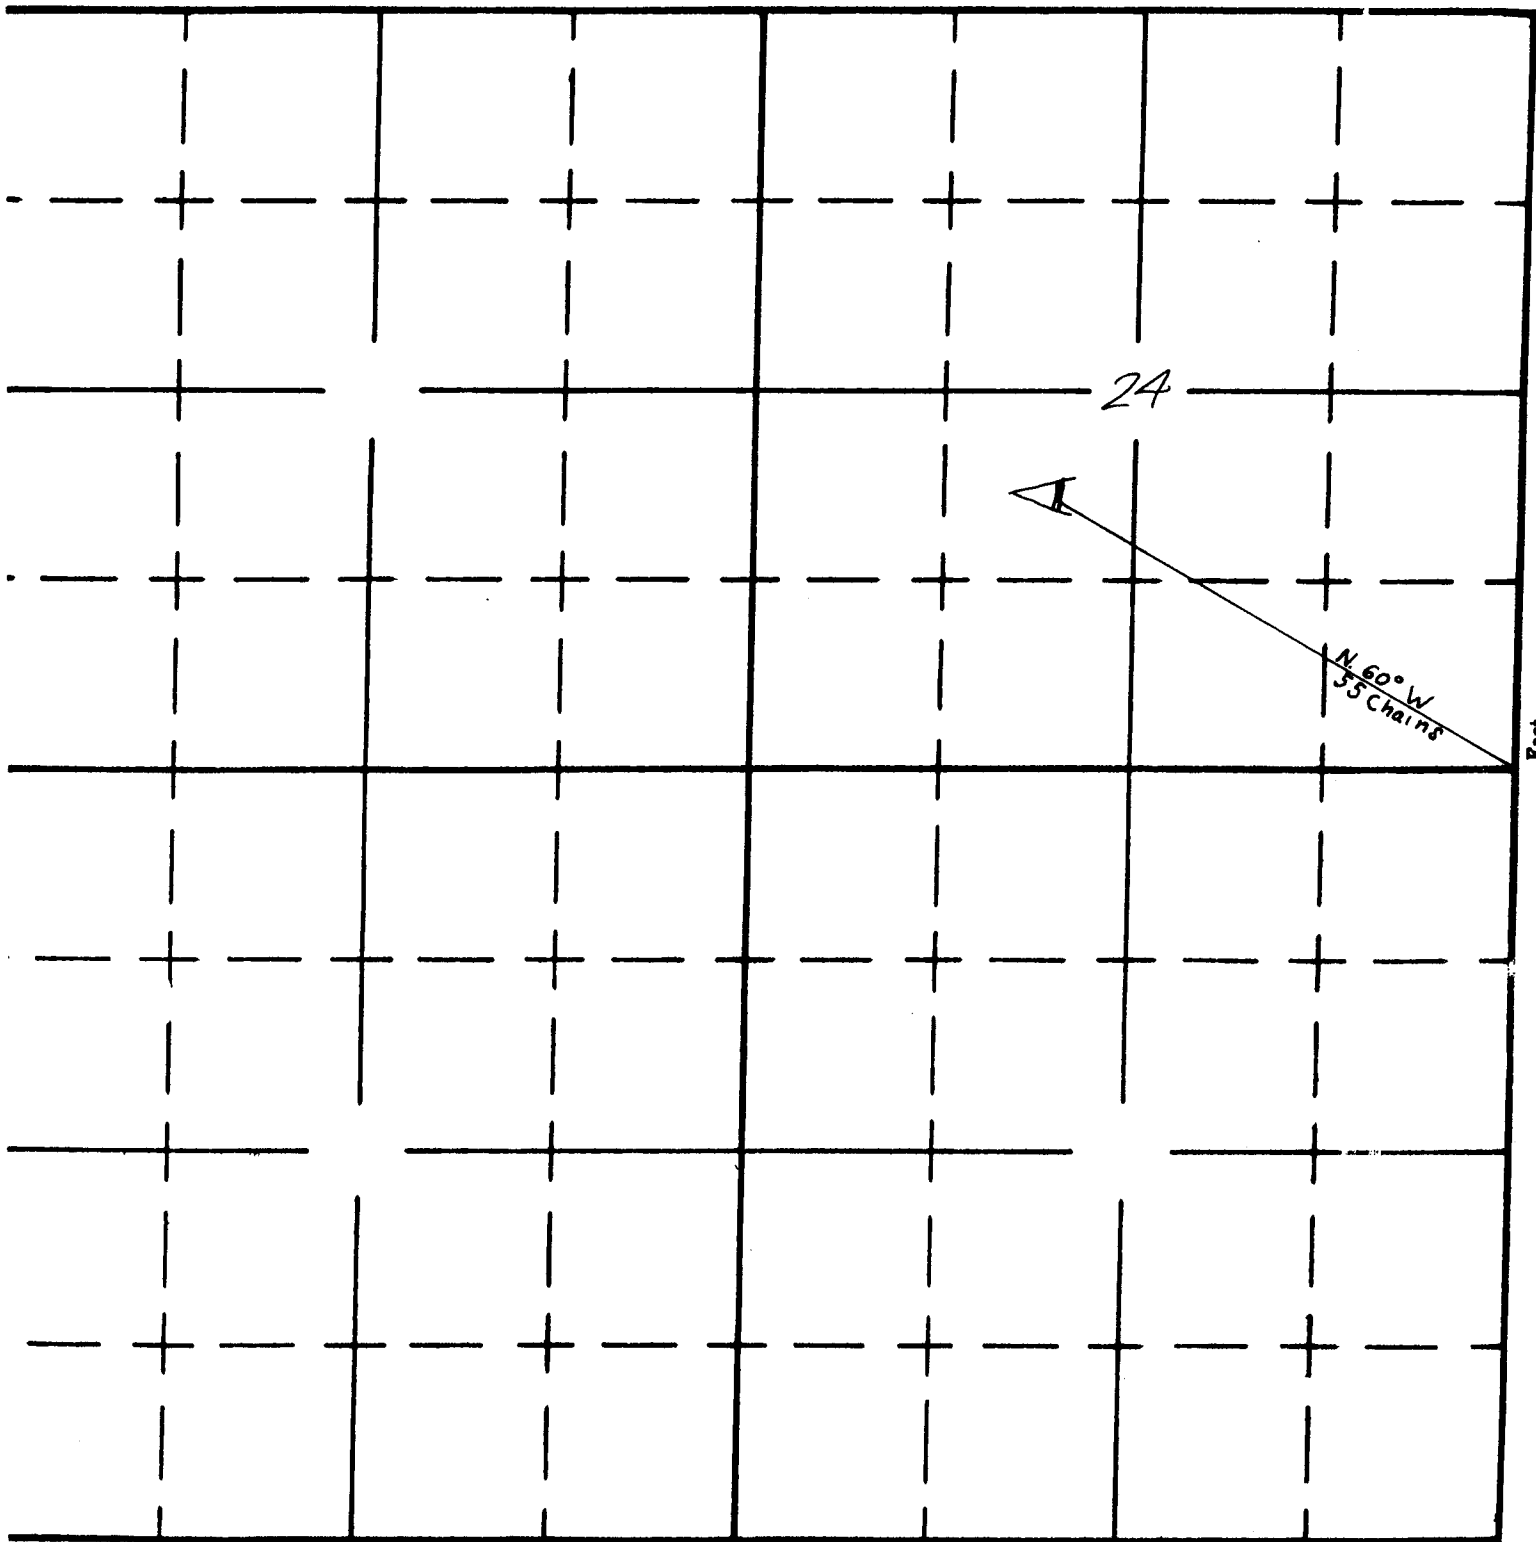

South

APPLICATION No. R-38276
R-3220