

UNITED STATES
DEPARTMENT OF THE INTERIOR
BUREAU OF LAND MANAGEMENT

Cabin 90 Reservoir

Oregon State Water Filings


SECTION

21

NE 1/4 NW 1/4

TOWNSHIP 40s, RANGE 3E, W. M.

North

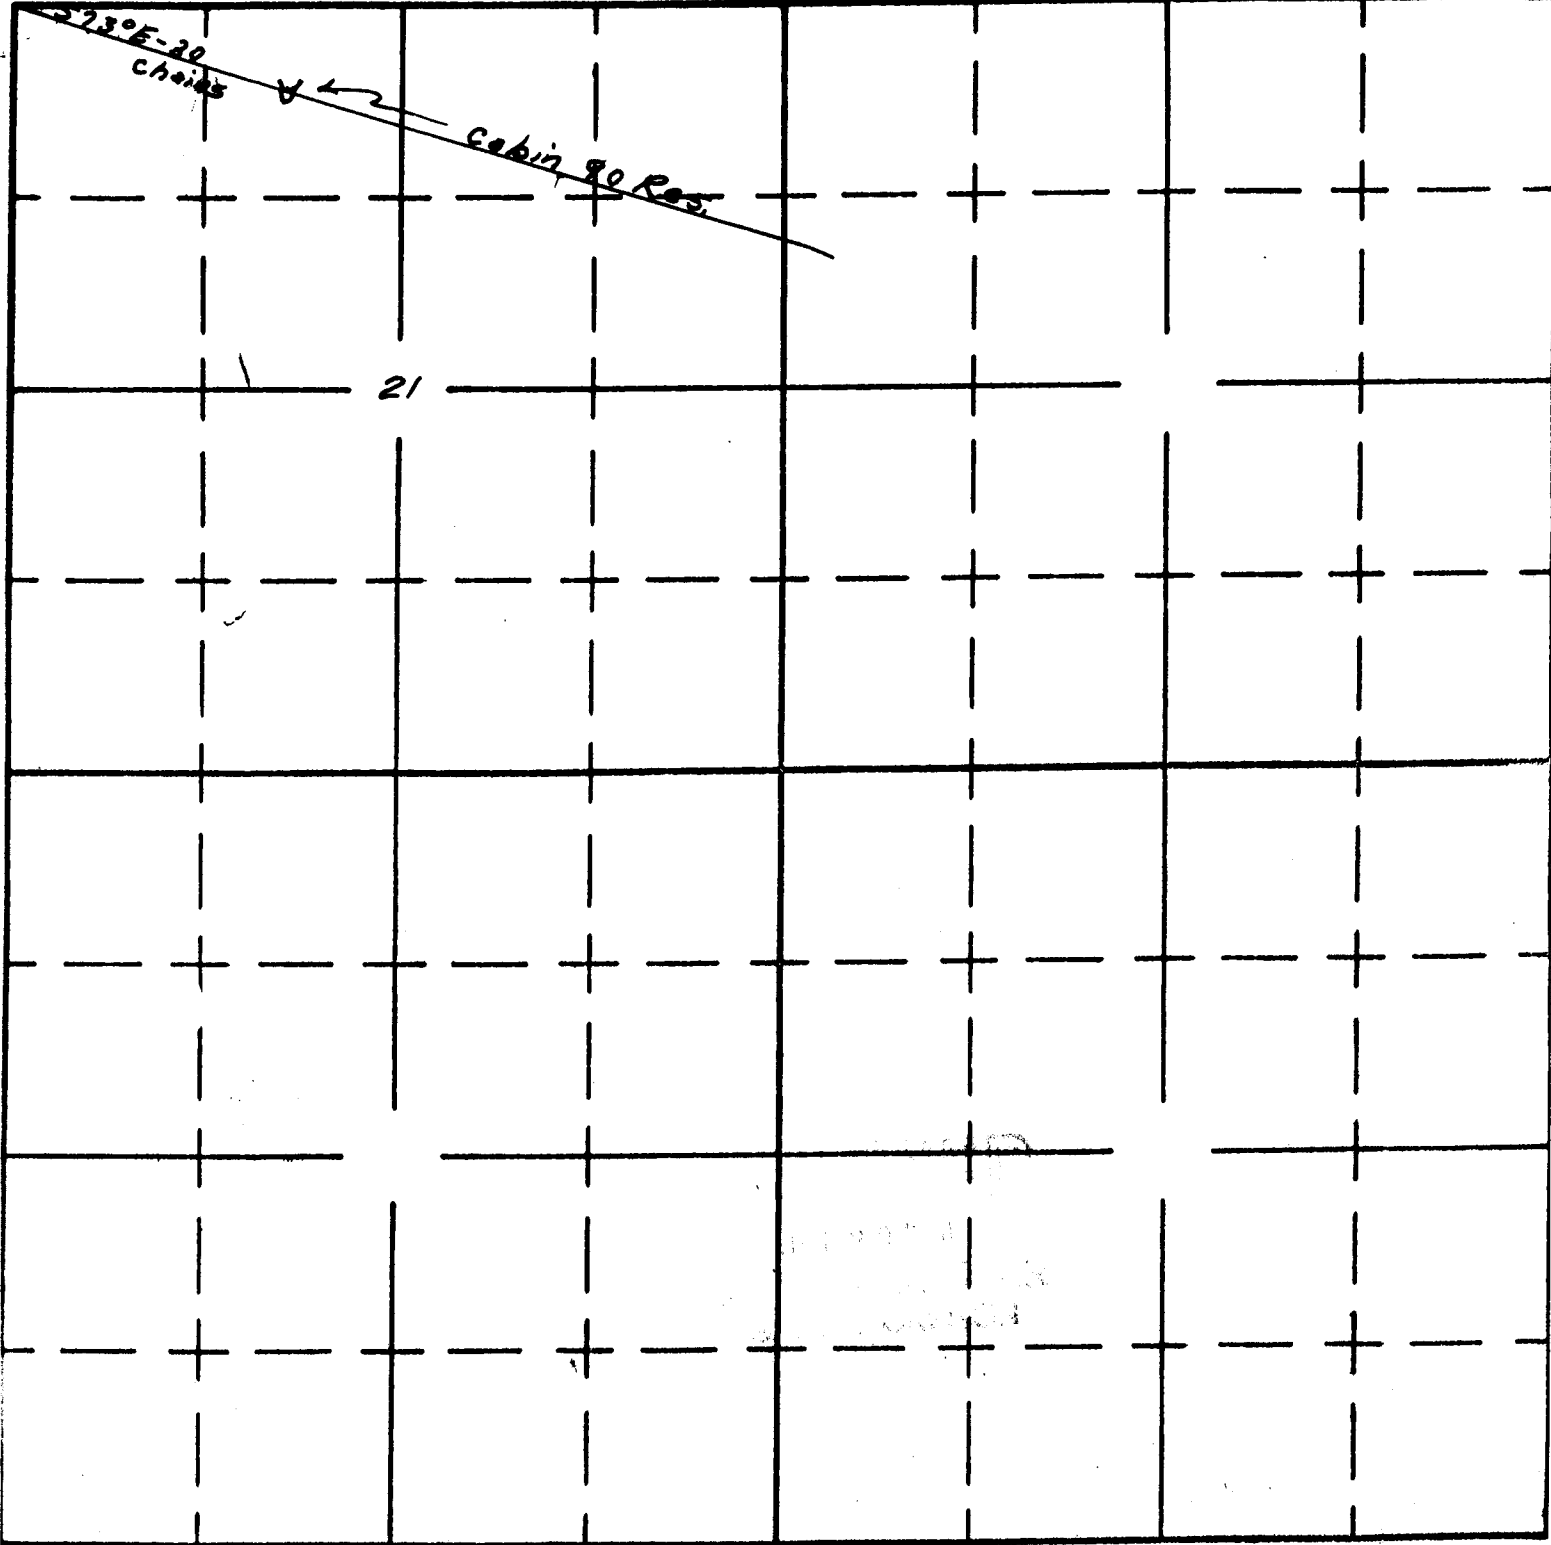

South

APPLICATION No. *R-35217*
PERMIT No. *R-3236*