

UNITED STATES
DEPARTMENT OF THE INTERIOR
BUREAU OF LAND MANAGEMENT


SECTION

17
NW 1/4 SE 1/4

Oregon State Water Filings

TOWNSHIP 40S, RANGE 3E, W. M.
North Baldy Res. or Baldy #1

North

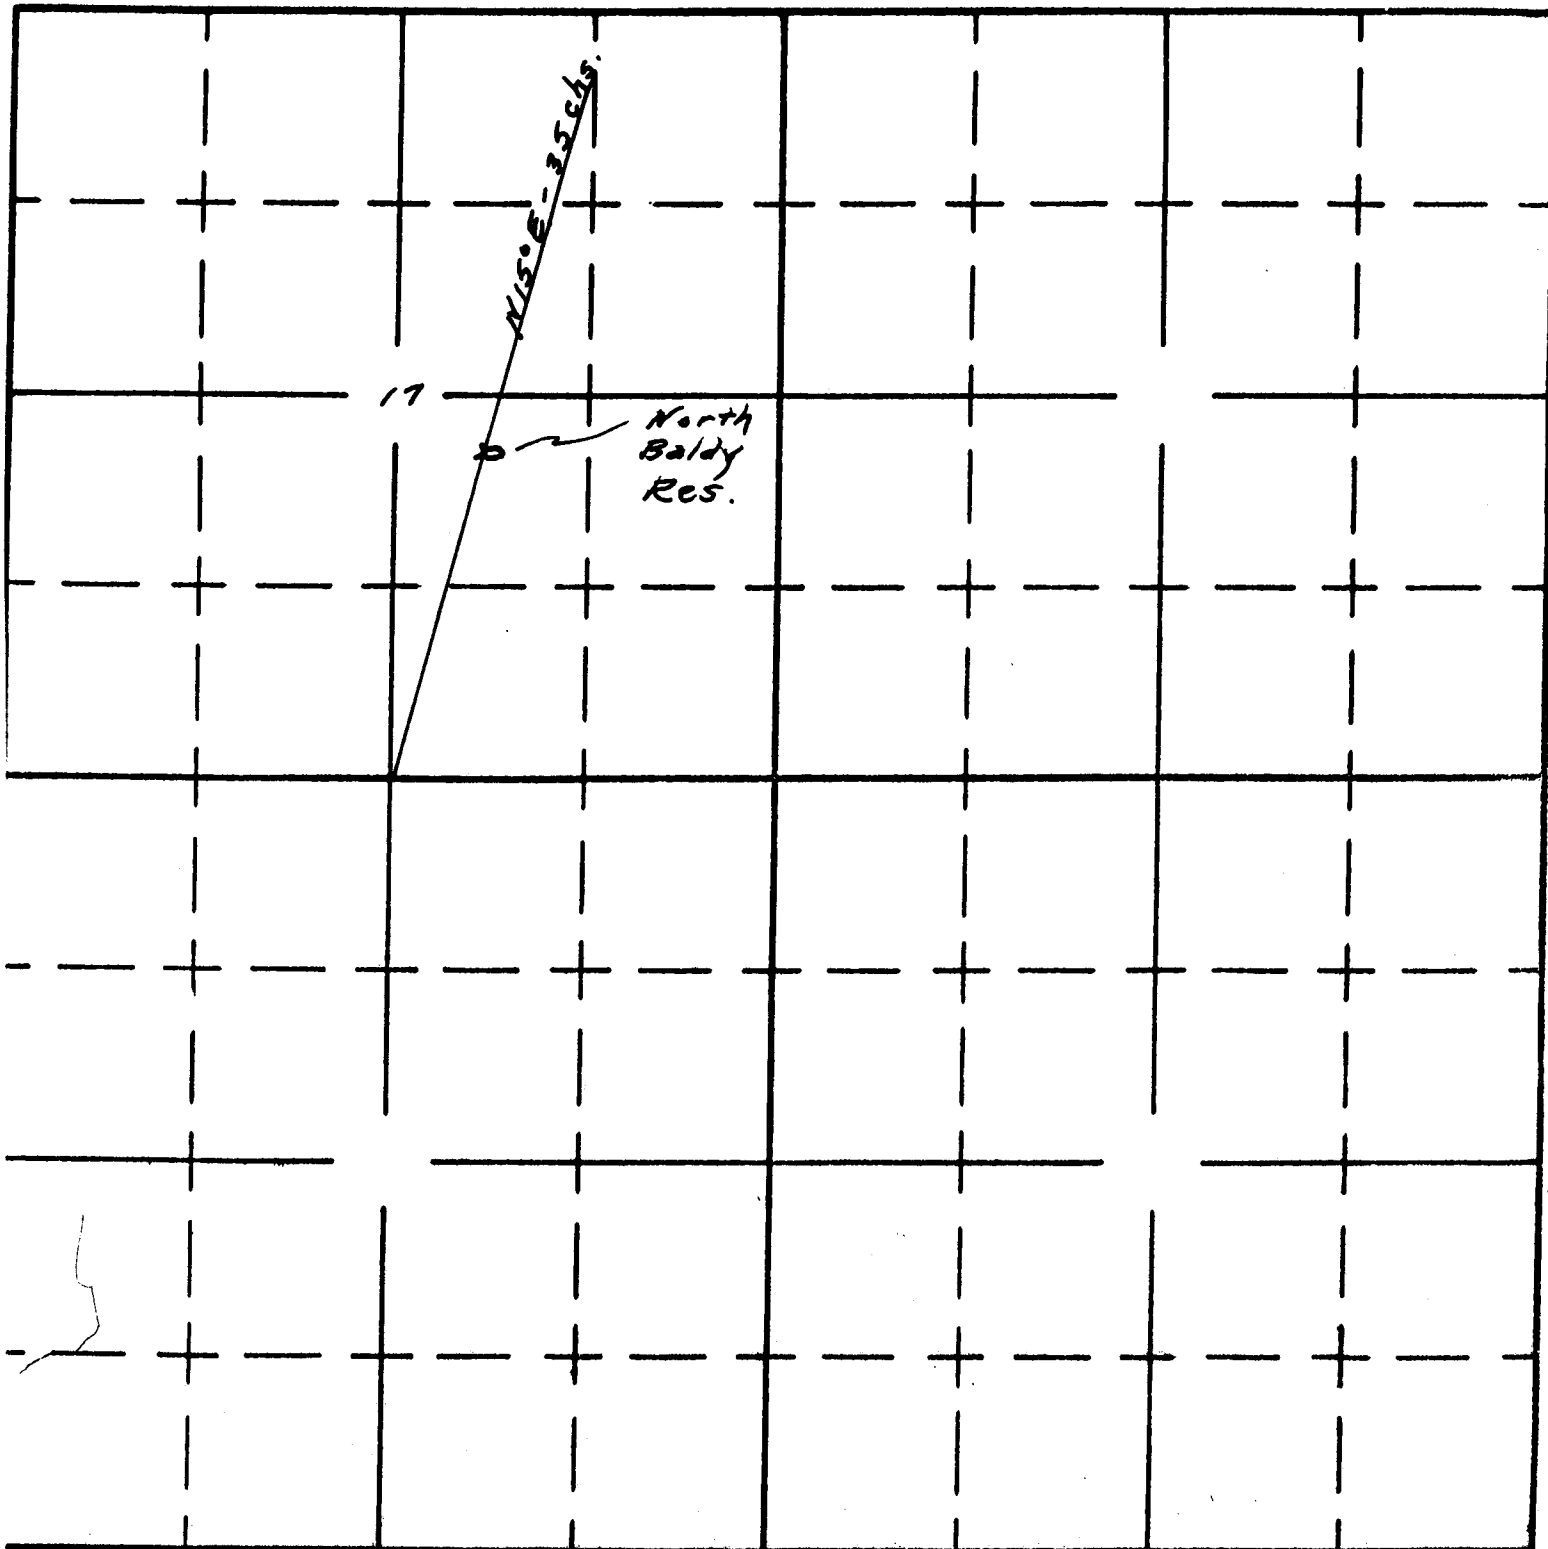

South

APPLICATION No. R-35221
PERMIT No. R-3240