

UNITED STATES  
DEPARTMENT OF THE INTERIOR  
BUREAU OF LAND MANAGEMENT


SECTION

17  
NW 1/4 SE 1/4


TOWNSHIP 40S, RANGE 3E, W. M.

*South Baldy Reservoir  
or Baldy<sup>North</sup> Reservoir #2*

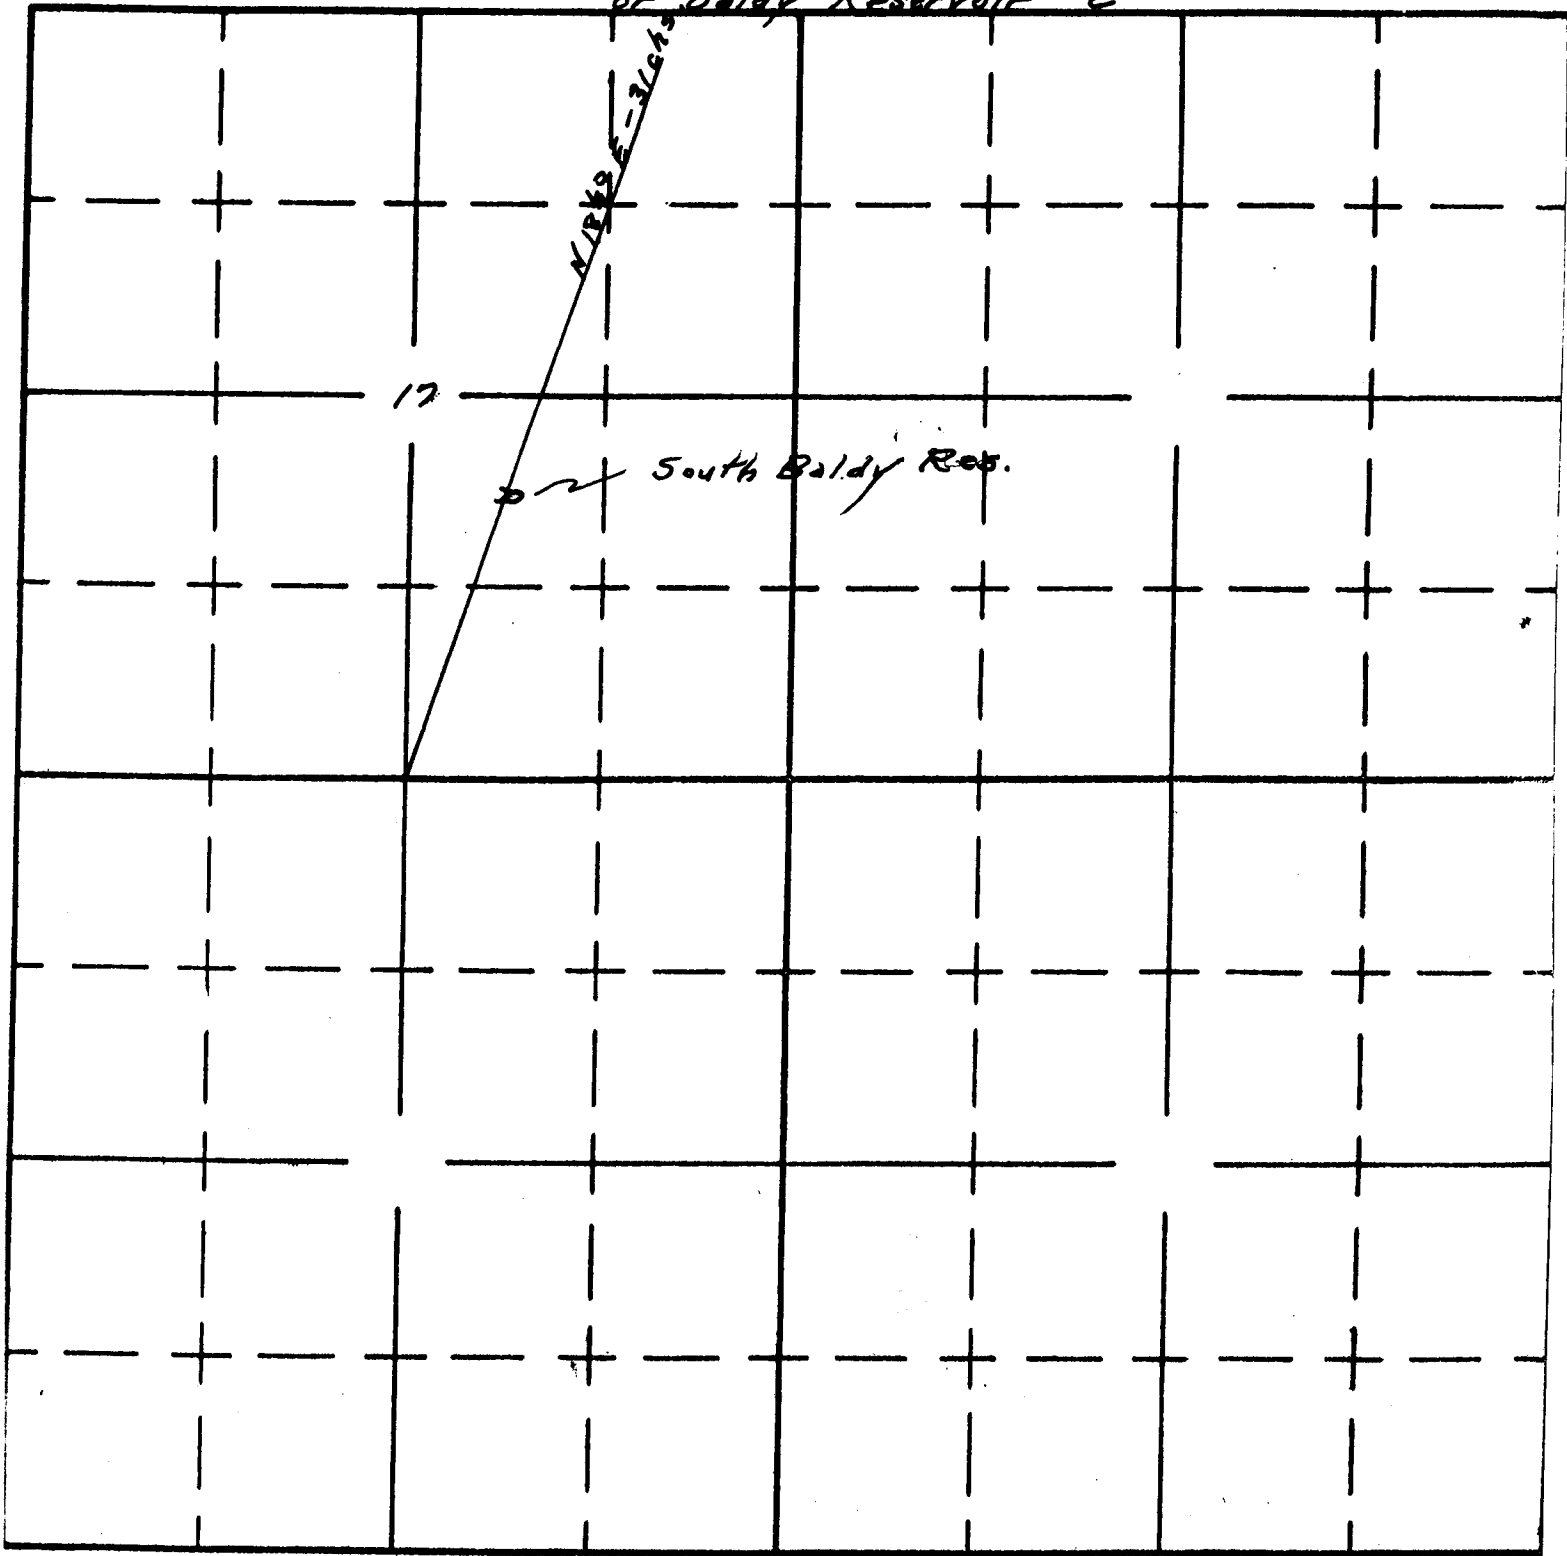

South

APPLICATION No. R-3522.  
PERMIT No. R-3241