

UNITED STATES
DEPARTMENT OF THE INTERIOR
BUREAU OF LAND MANAGEMENT

SECTION


25

Oregon State Water Filings

TOWNSHIP 9S, RANGE 40E, W. M.

North

~~06-378-397~~

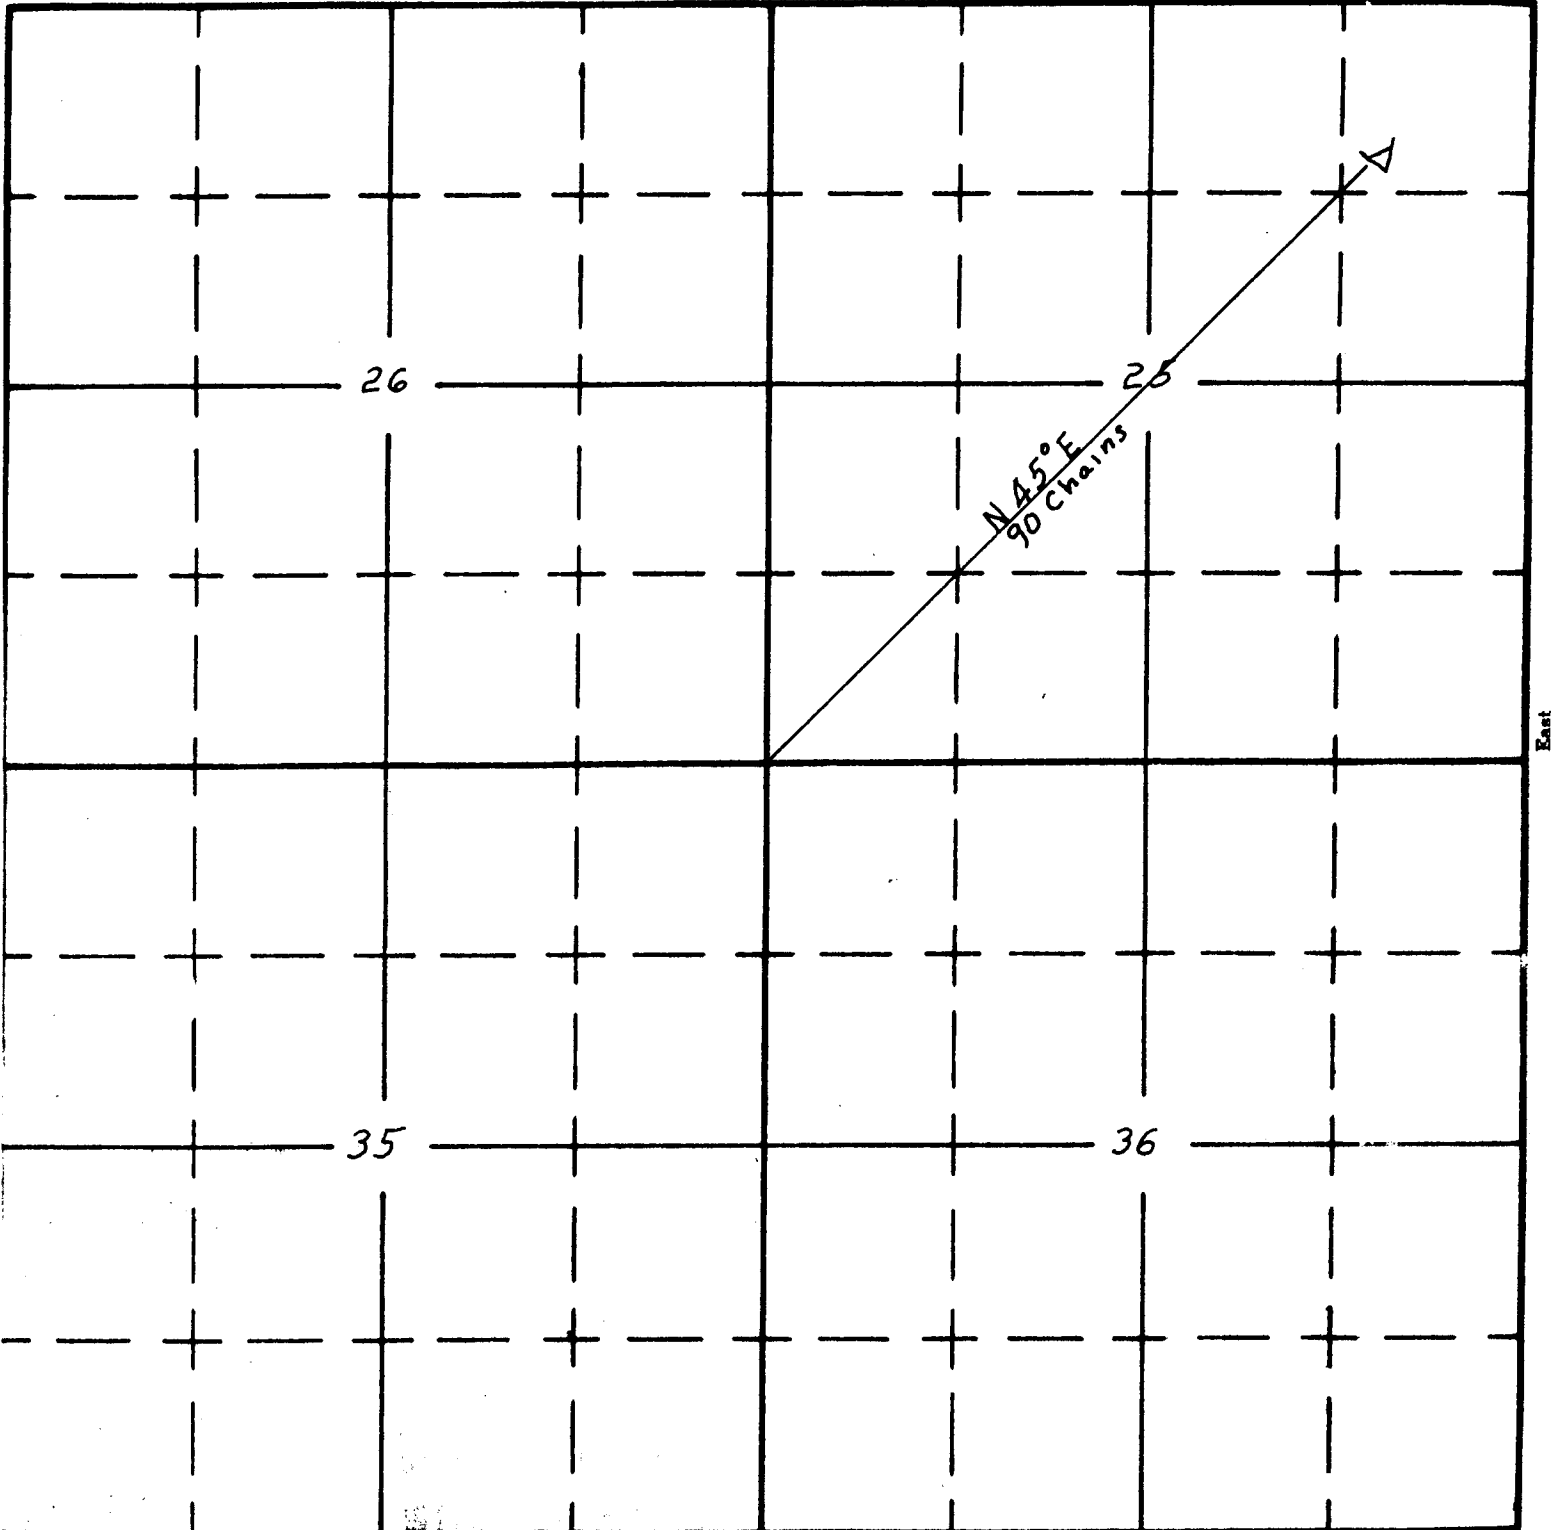

Application No. R-38727
Permit No. R-3274

South

APPLICATION No.
PERMIT No.