

UNITED STATES
DEPARTMENT OF THE INTERIOR
BUREAU OF LAND MANAGEMENT

SECTION


13

Oregon State Water Filings

TOWNSHIP 10S, RANGE 42E, W. M.

North

06-410

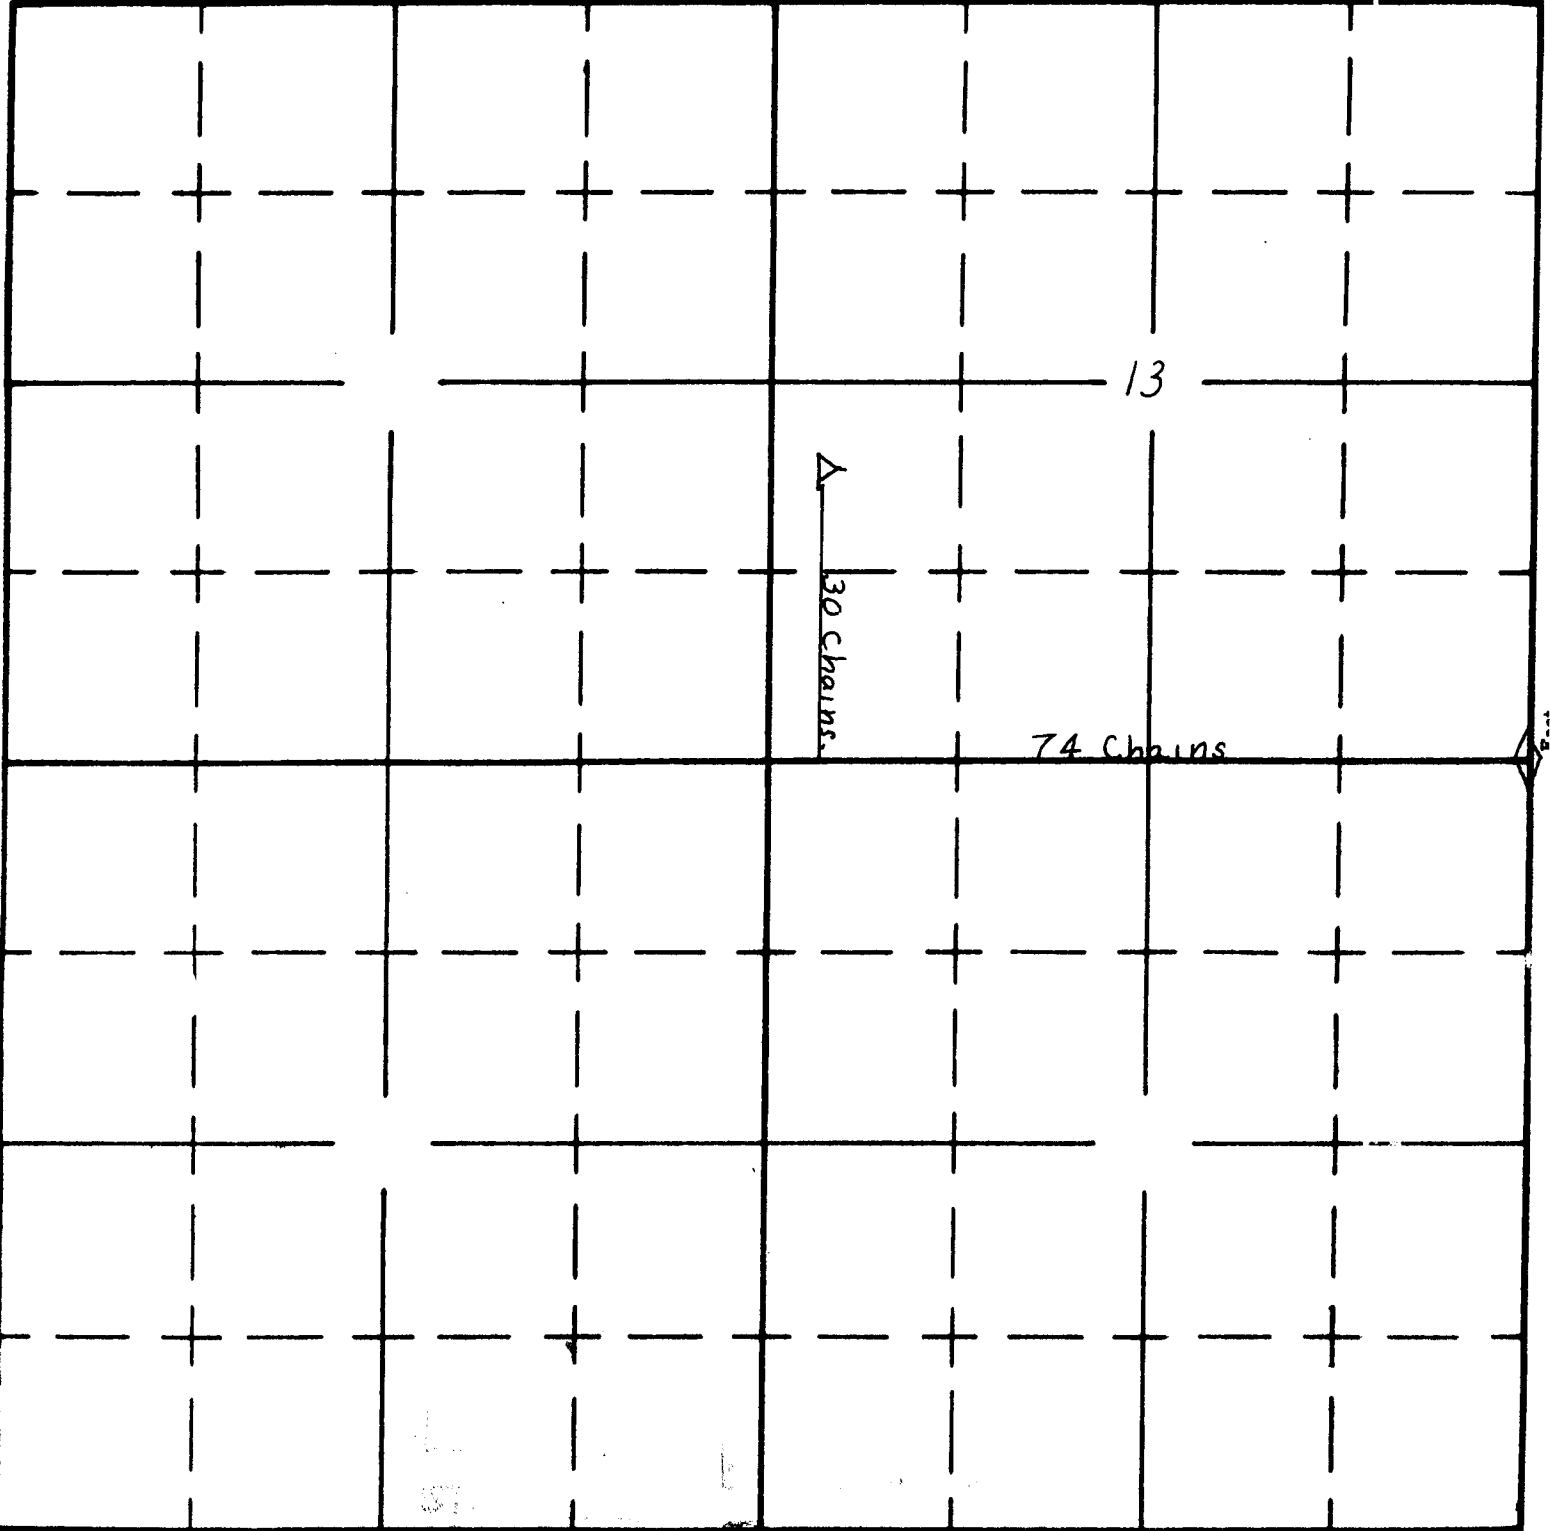

Application No. R-38729
Permit No. R-3276

South

APPLICATION No.
PERMIT No.