

UNITED STATES
DEPARTMENT OF THE INTERIOR
BUREAU OF LAND MANAGEMENT


SECTION
13

Oregon State Water Filings

TOWNSHIP 9S, RANGE 46E, W. M.

North

06-243

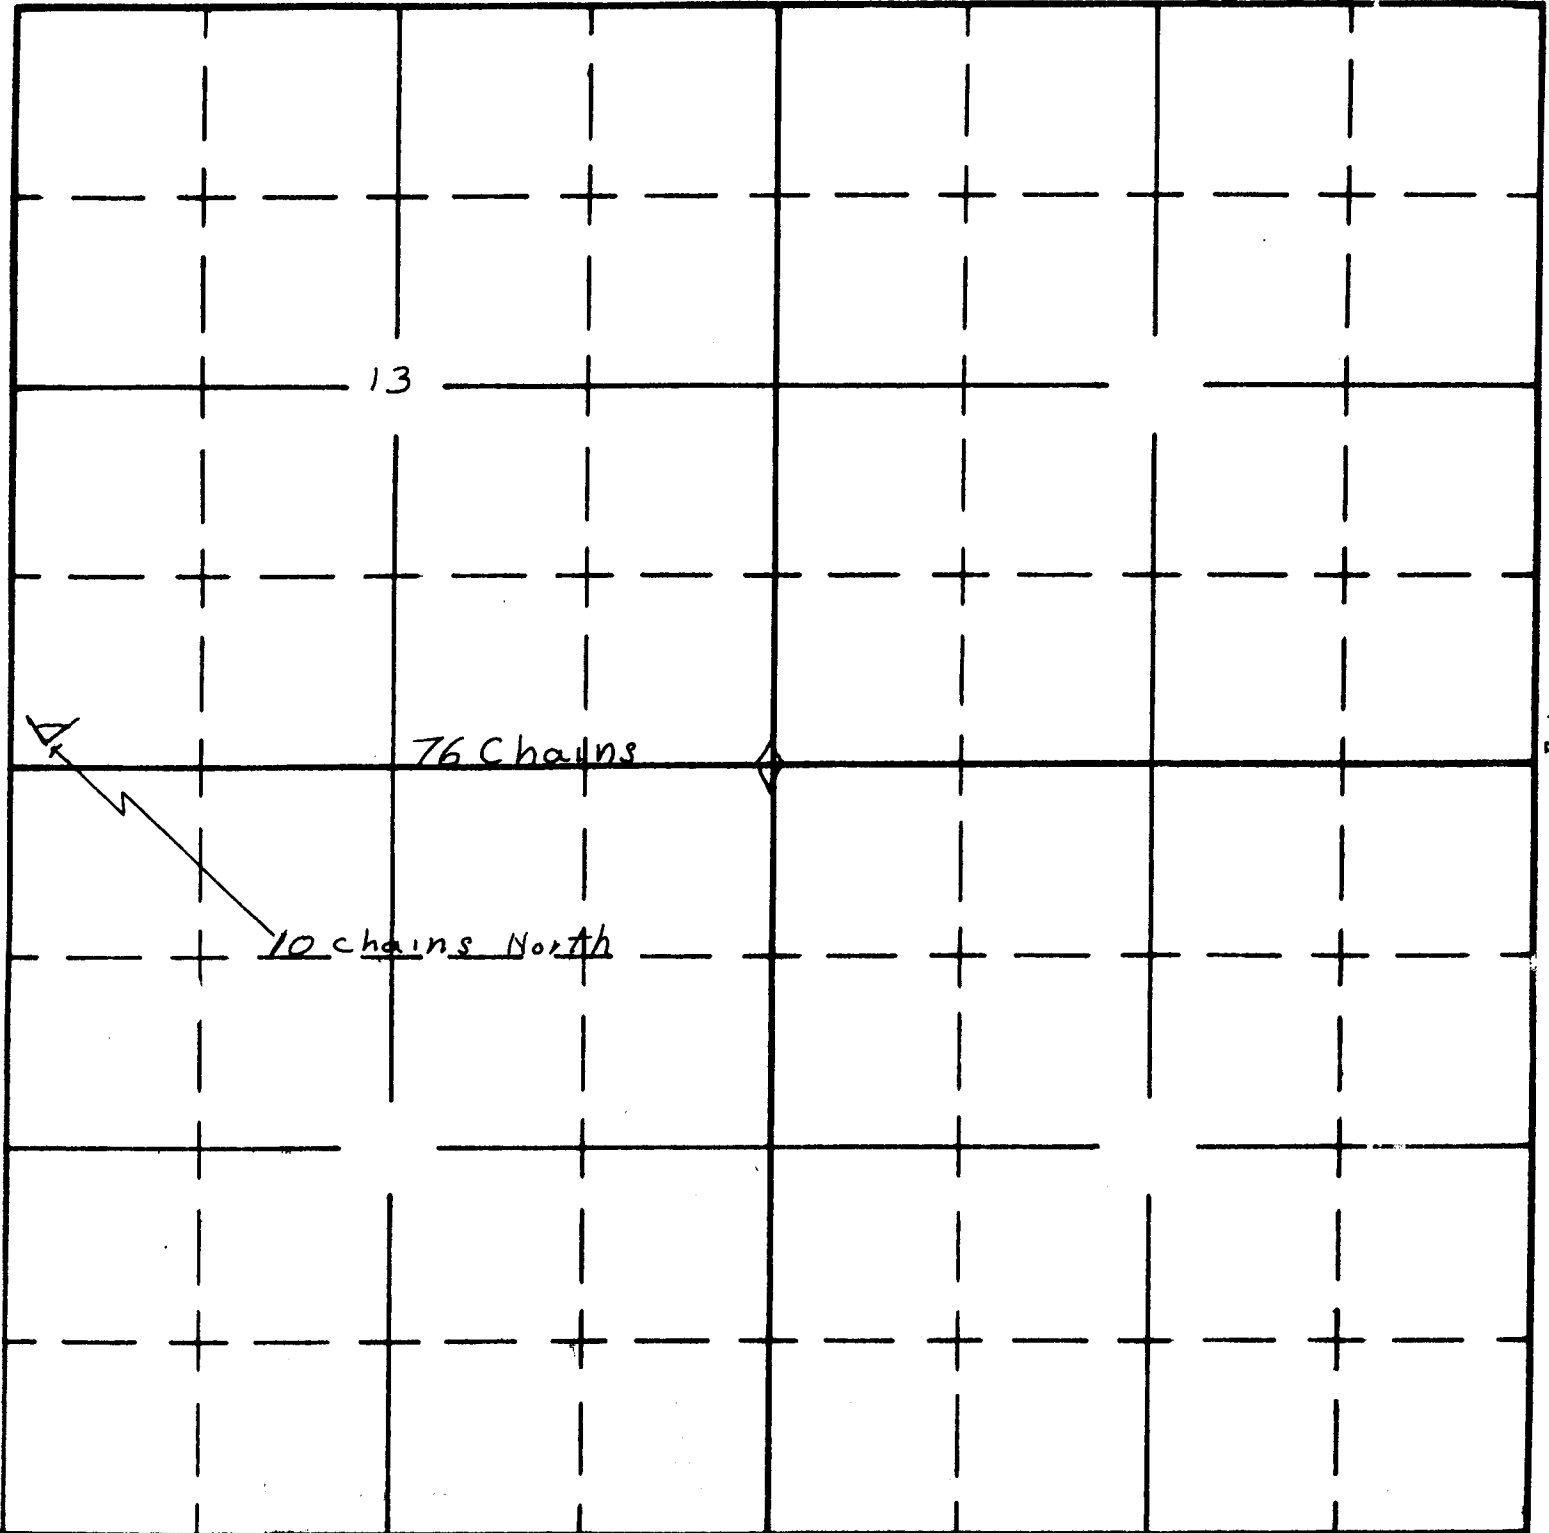

Application No. R-38730
Permit No. R-3277

South

APPLICATION No.
PERMIT No.