


UNITED STATES
DEPARTMENT OF THE INTERIOR
BUREAU OF LAND MANAGEMENT

SECTION 30

Oregon State Water Filings

TOWNSHIP 13S, RANGE 44E, W. M.

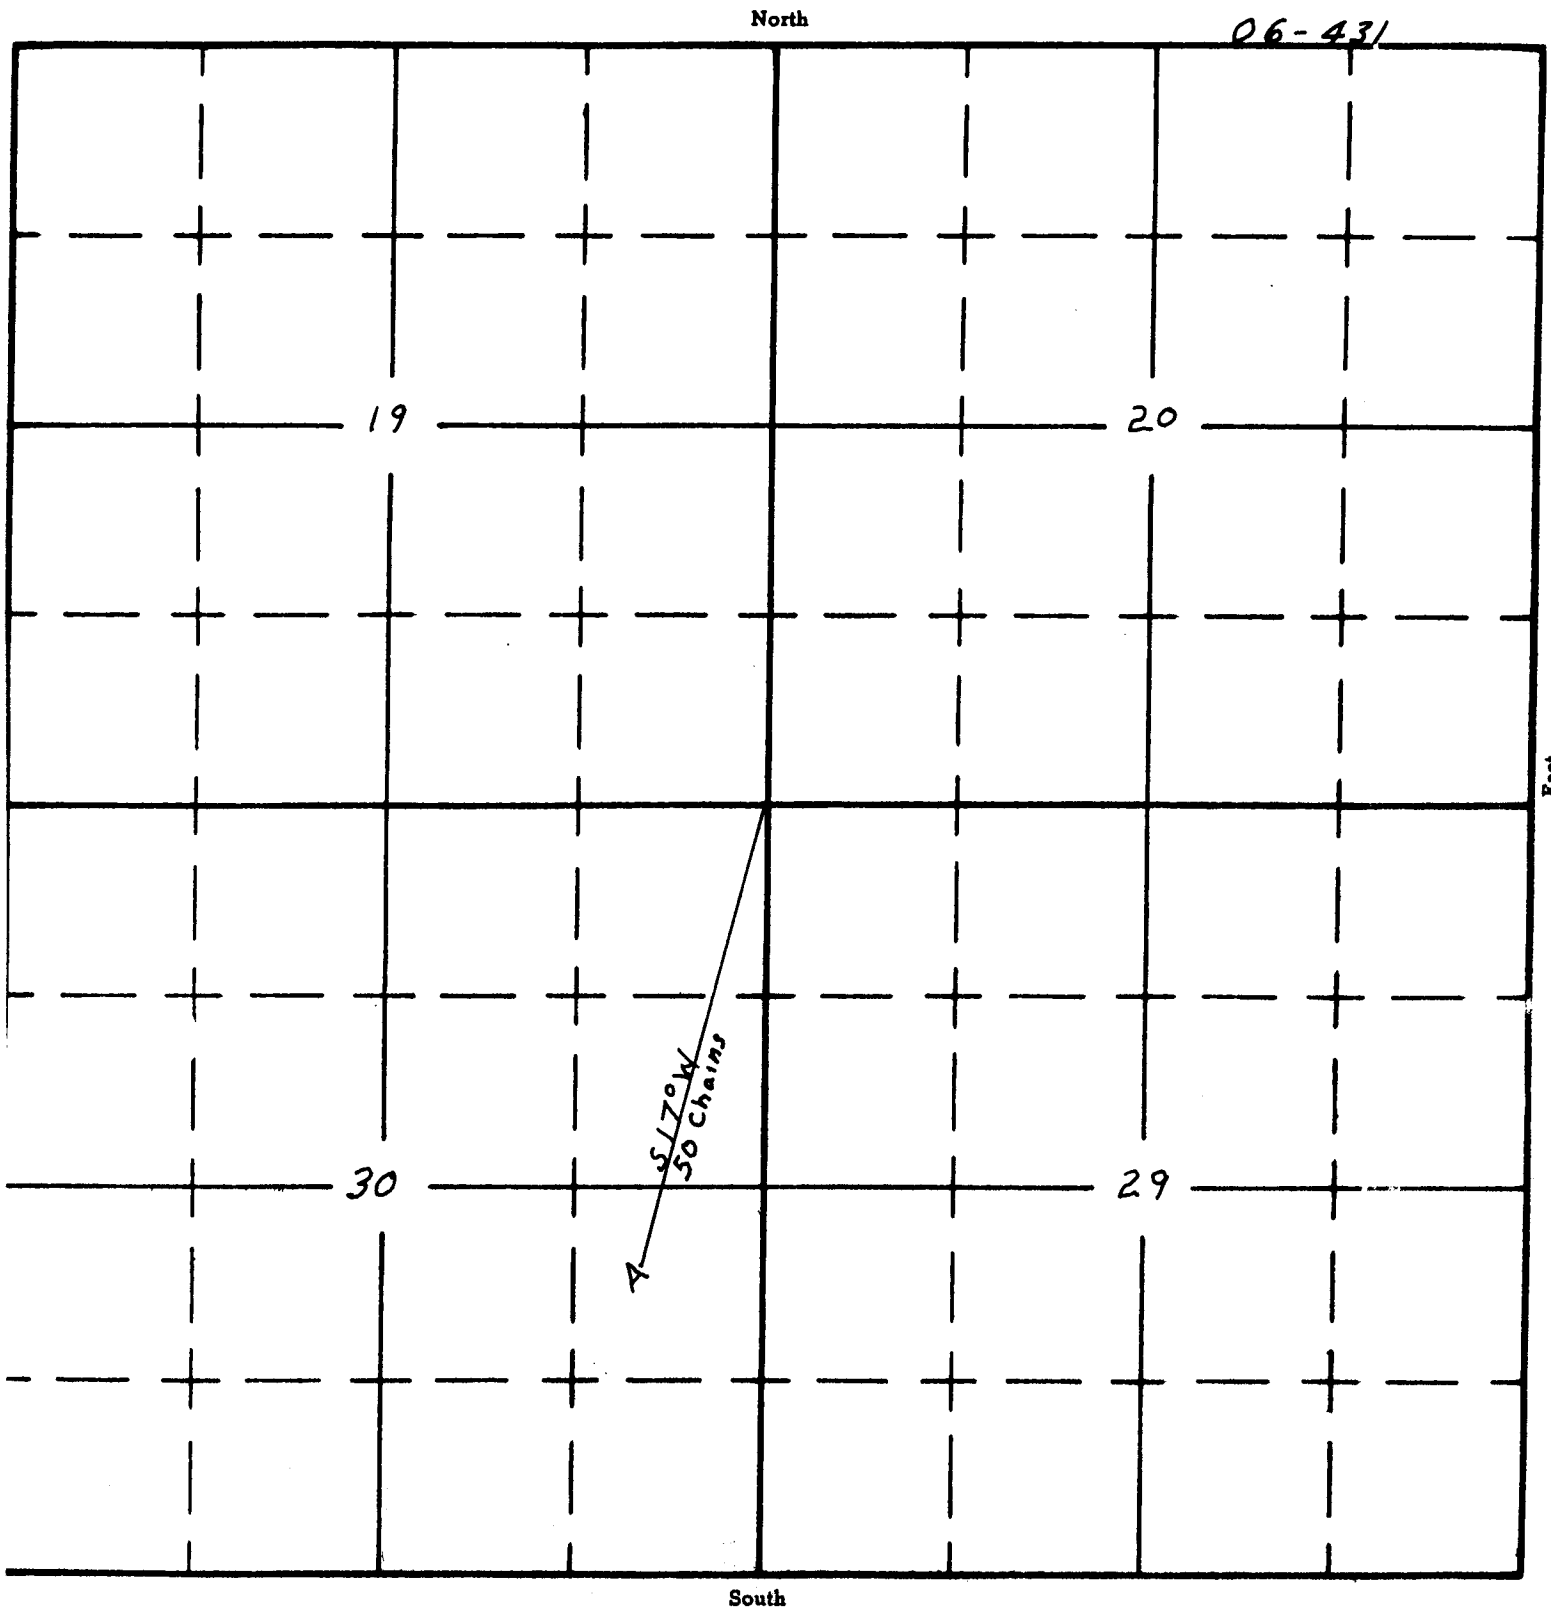

APPLICATION No. R-3873
PERMIT No. R-3279