





T. 34 S., R. 1 W., W.M.
 SEC. 21

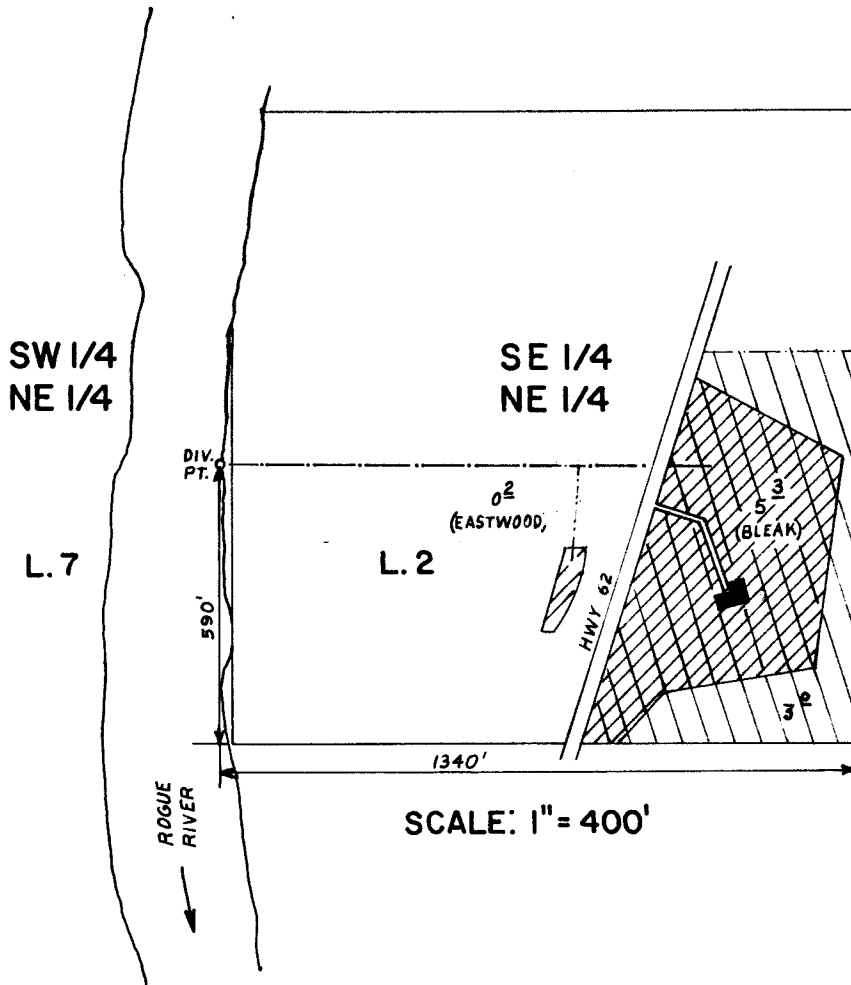

SCALE: 1" = 400'

-  PRIMARY permit 41179
-  Primary 48276 & Supplemental
-  Supplemental 48276

FINAL PROOF SURVEY
 UNDER

67438 48276
 Application No. **52564** Permit No. **41179**
 IN NAME OF

GENE BLEAK and WAYNE W. & ELIZABETH A. EASTWOOD

Surveyed **JUNE 24 1983**, by **B. S. JAMES**