


map 1 of 2

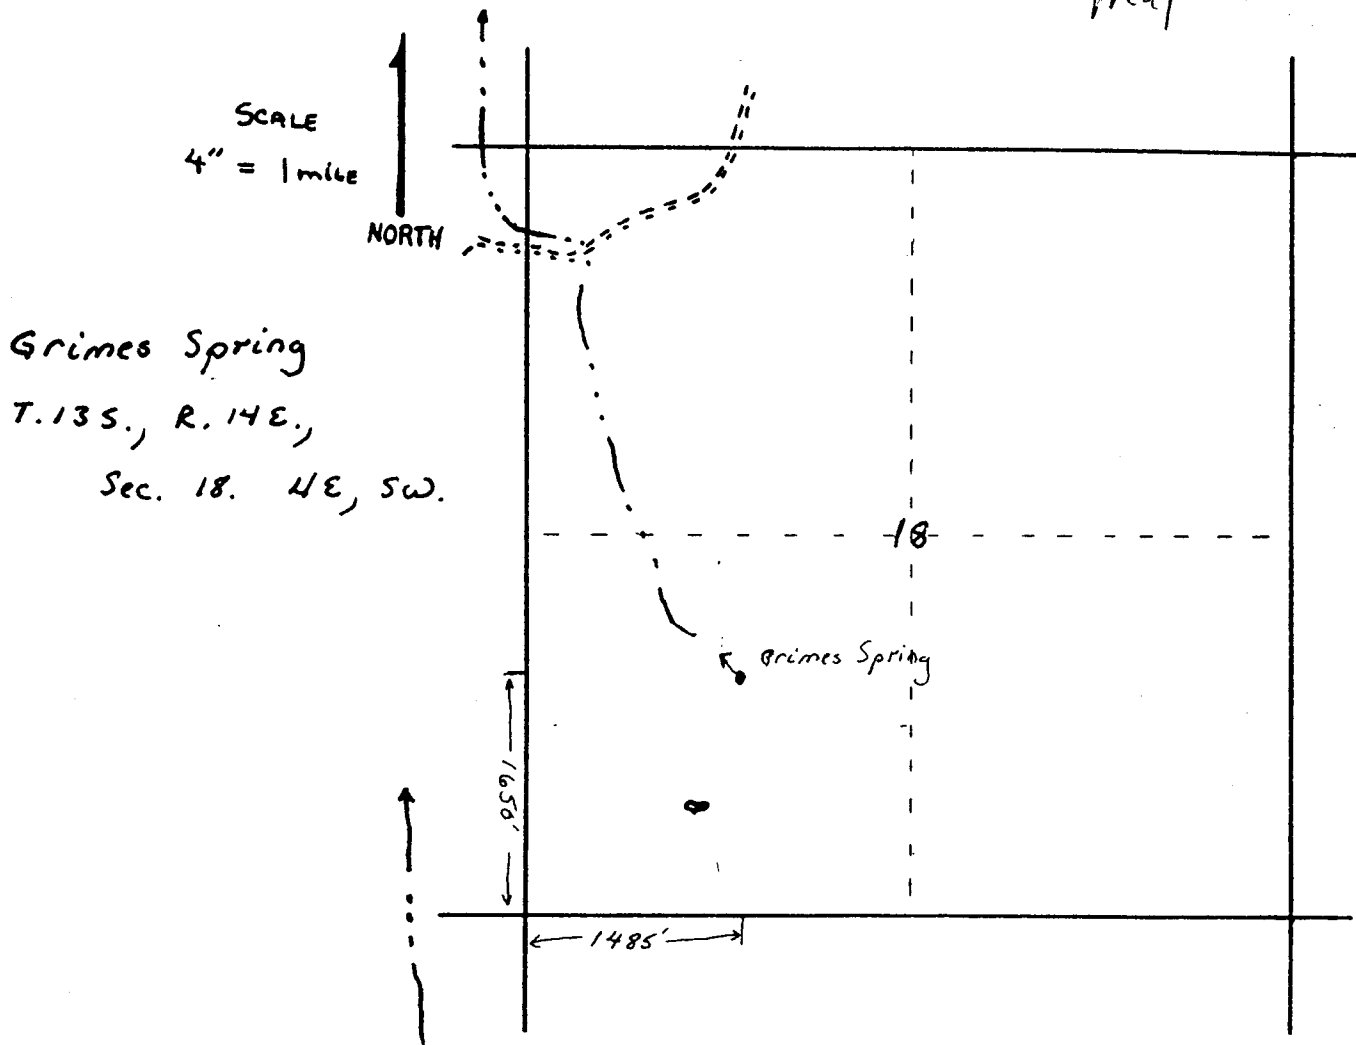

defunct
stock tank →

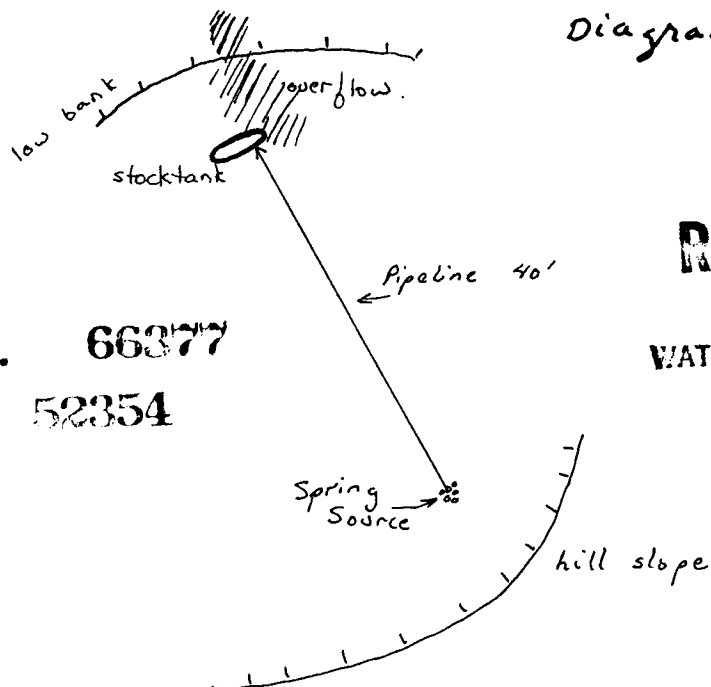


Diagram of Development
1" = 20'

N

Application No. 66377
Permit No. 52354

RECEIVED
SEP 19 1983
WATER RESOURCES DEPT.
SALEM, OREGON

Map 2 of 2

SCALE
4" = 1 mile

NORTH

550

Upper Cyrus Spring

Upper Cyrus Spring

T. 13 S., R. 14 E.,

Section 18, NW, NW

18

Application No. 66377

Permit No. 52354

Diagram 1 inch = ~100 feet.

overflow

Stock trough

dirt Roads

Pipeline

intermittent stream

Upper Cyrus Orchard
Enclosure

Stock troughs

East Cyrus Pasture

Poplar trees

Road to Cyrus Hill Pond

spring source marked
with pipe in hillside

Low Hillside

RECEIVED

SEP 19 1983

WATER RESOURCES DEPT.
SALEM, OREGON