


File Copy
Do Not Remove

T. 34 S., R. 19 E., W.M.

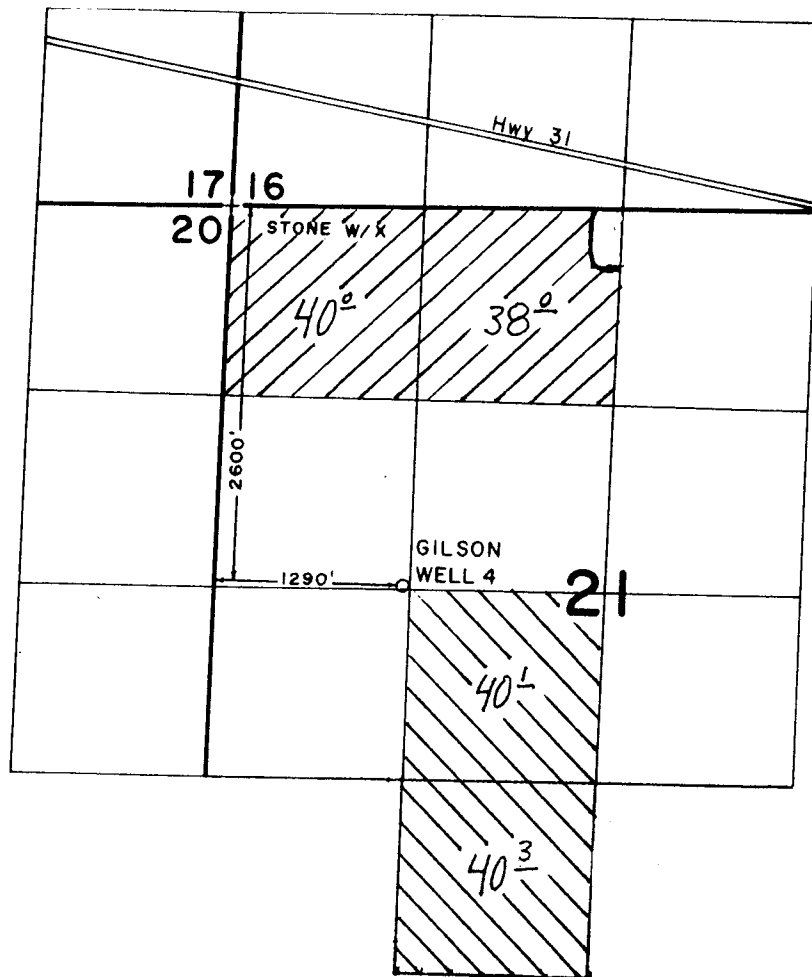

 T-5943

 G-7388

SCALE: 1" = 1320'

FINAL PROOF SURVEY
UNDER

TRANSFER NO. 5943

Application No. G-7890, Permit No. G-7388
IN NAME OF

J-SPEAR RANCH COMPANY

Surveyed APRIL 4, 1990, by B.W. BISHOP

Revised 6/5/03 GEC

5-17-90
41037-379-110 L