
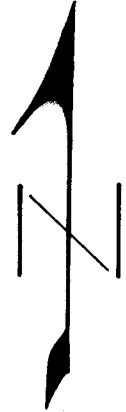


T15S, R15E W.M.

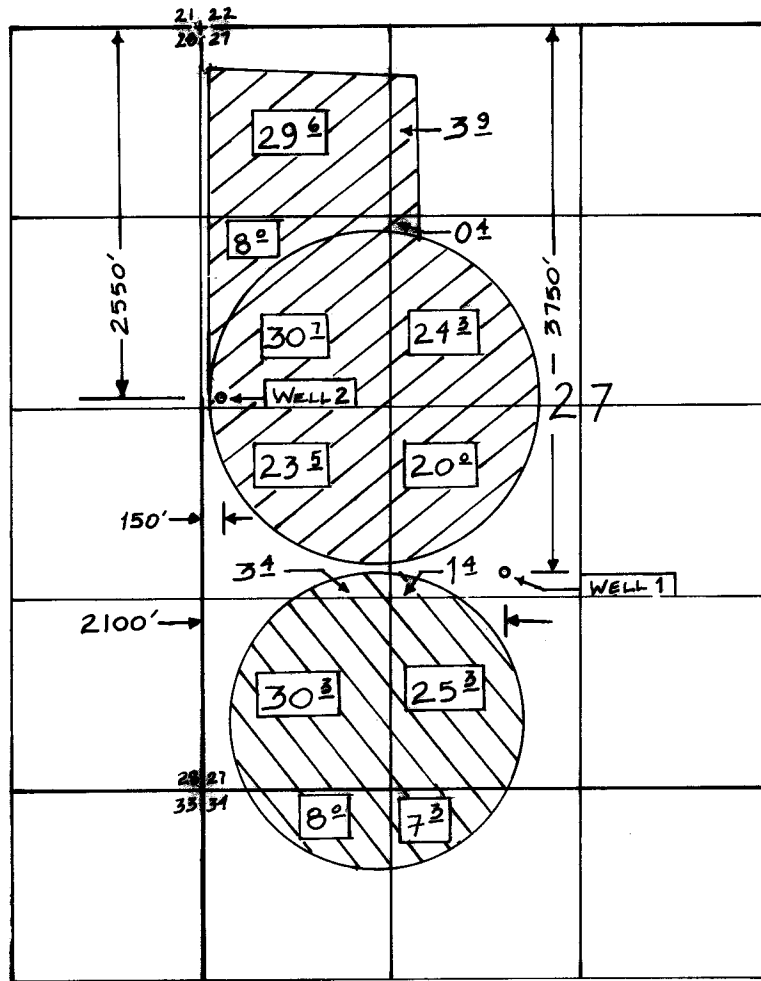

SCALE: 4 in/mi
1" = 1320'

**FINAL PROOF SURVEY
UNDER**

Application No. G-11194 Permit No. G-10609
IN NAME OF

R. RAASCH - 3 SPRINGS RANCH

Surveyed AUG. 26th 2002 by EPL & JG

RECEIVED

NOV 19 2002

