


T. 9S, R. 4W, W.M.

RECEIVED

JUL 07 1998

STATE OF OREGON  
DEPARTMENT OF LAND AND FORESTRY

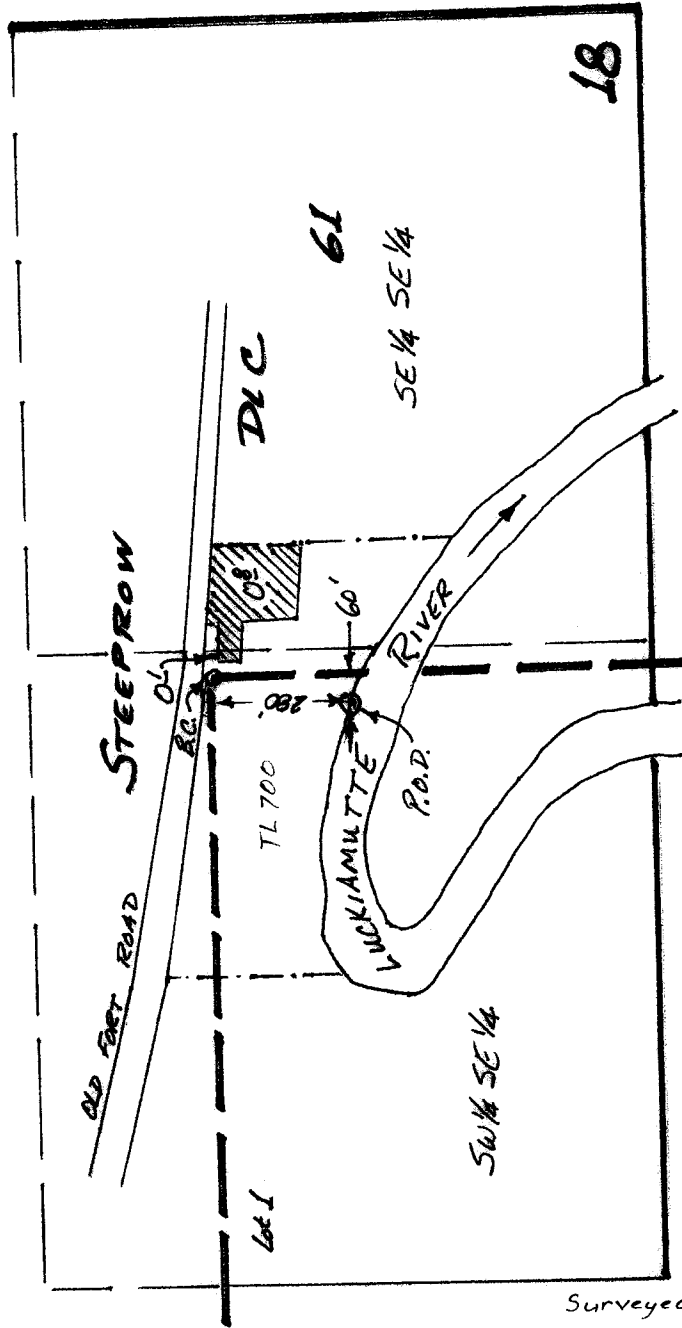

Surveyed Oct 27, 1998

### Claim of Beneficial Use Map

for  
**SHARON SAFINA**  
Permit No. 52030



THIS MAP WAS PREPARED FOR THE PURPOSE OF IDENTIFYING THE LOCATION OF A WATER RIGHT ONLY AND IS NOT INTENDED TO PROVIDE LEGAL DIMENSIONS OR LOCATION OF PROPERTY OWNERSHIP LINES.

