


T27S, R5W, WM

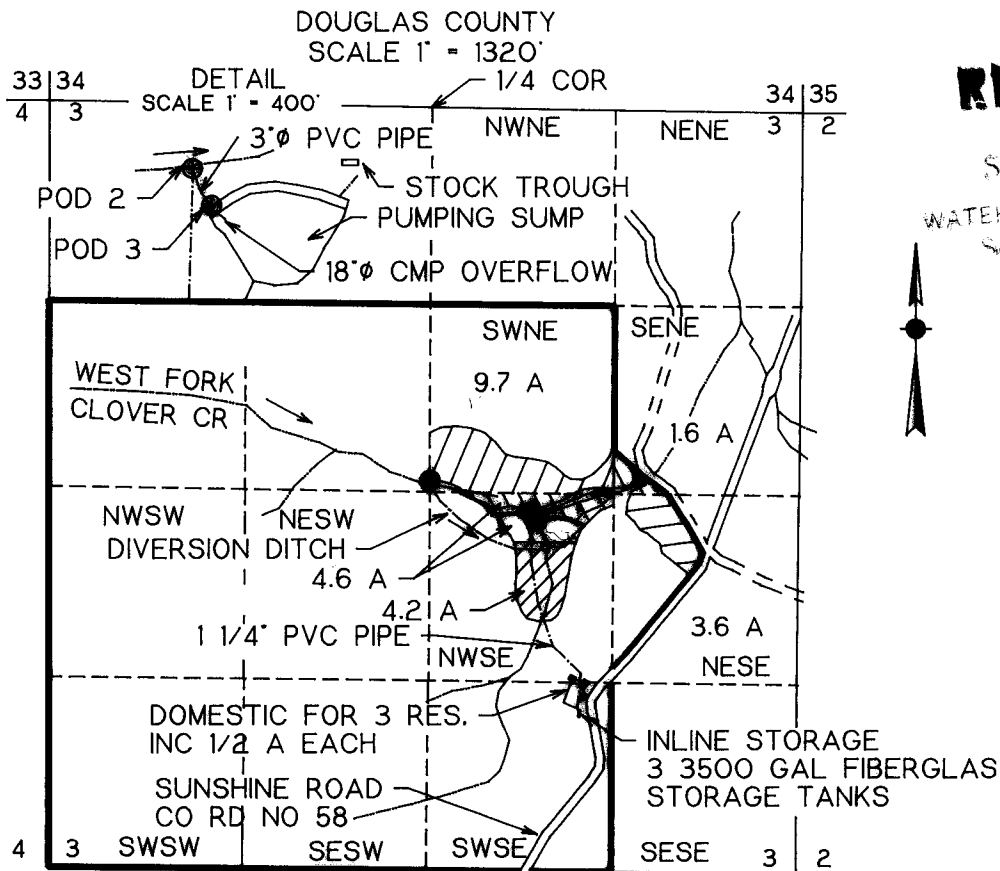

RECEIVED

SEP 27 1995
WATER RESOURCES DEPT.
SALEM, OREGON

POD 1 IS 2640 FT S AND 0 FT E FROM 1/4 COR SEC 34/3
POD 2 IS 2800 FT S AND 750 FT E FROM 1/4 COR SEC 34/3
POD 3 IS 2900 FT S AND 790 FT E FROM 1/4 COR SEC 34/3

FINAL PROOF SURVEY UNDER

Application No. 69874 Permit No. 51206

IN NAME OF

W.T. DAWSON

Surveyed Sept 15, 1995 by M.E. Farr

THIS IS A LOCATION MAP FOR A FINAL PROOF SURVEY
BY W.T. DAWSON. THIS MAP IS FOR THE PURPOSE OF
IDENTIFYING THE LOCATION OF THE WATER RIGHT ONLY
AND IS NOT INTENDED TO PROVIDE LEGAL DIMENSIONS OR
LOCATIONS OF PROPERTY OWNERSHIP LINES.



EXPIRES 12-31-95