


T.3N., R.9W., W.M.

RECEIVED


OCT 07 2002

WATER RESOURCES DEPT.
SALEM, OREGON

SECTION 7

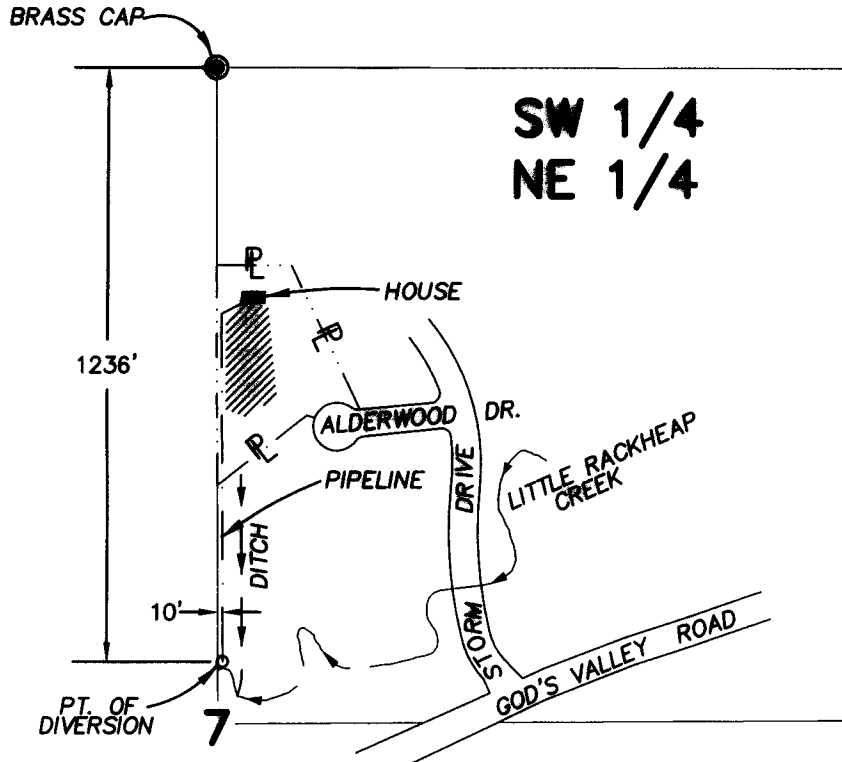

SCALE:
1" = 400'

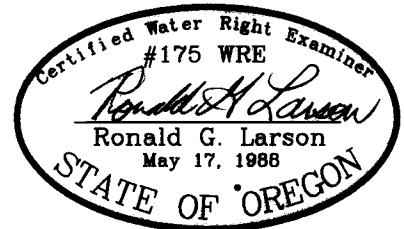

RENEWAL DATE: DECEMBER 31, 2002

FINAL PROOF SURVEY

UNDER

APPLICATION NO. S-73714, PERMIT NO. 52068

IN THE NAME OF

CARY & GAIL ZINK

SURVEYED SEP. 23, 2002

FILE: 1902-11265-01-01.DWG

THE PURPOSE OF THIS MAP IS TO IDENTIFY THE LOCATION OF THE WATER RIGHT. IT IS NOT INTENDED TO PROVIDE INFORMATION RELATIVE TO THE LOCATION OF PROPERTY OWNERSHIP BOUNDARY LINES.

HLB & ASSOCIATES, INC.
SURVEYING • ENGINEERING • PLANNING

4253A HWY 101 N.
GEARHART, OR 97138
(503) 738-3425
FAX: (503) 738-7465