


RECEIVED

SEP 18 1994

WATER RESOURCES DEPT
914 340 0800

Township 5 South, Range 3 West, W.M. Section 6

Tax Lot No. 500

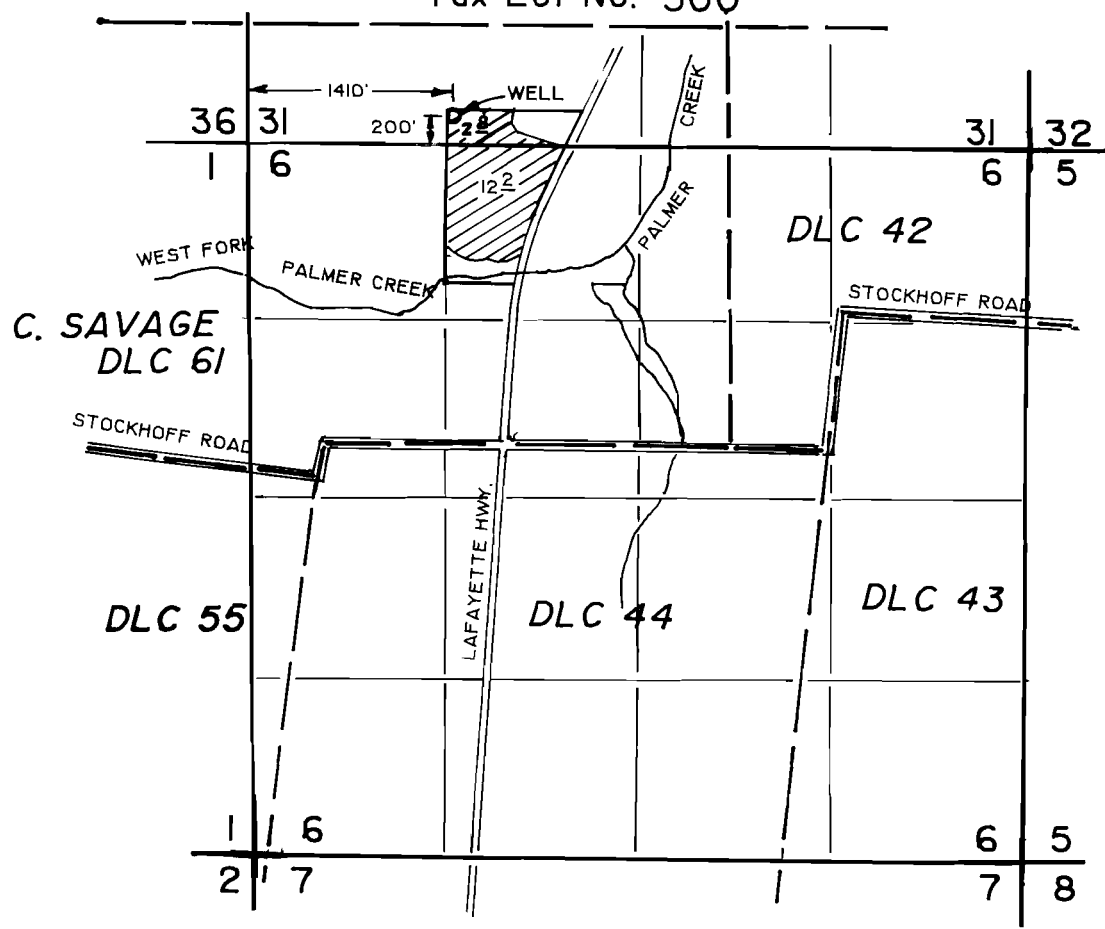

Appl. No. G-13892
Permit No. G-12946

FINAL PROOF SURVEY
for
KENNETH D. MONAGON

Certified Water Right Examiner
#380 WRE
Gene A. Miller
GENE A. MILLER
May 11, 1994
STATE OF OREGON
Exp. 12/31/98

THIS MAP WAS PREPARED FOR THE PURPOSE OF IDENTIFYING THE LOCATION OF A WATER RIGHT ONLY AND IS NOT INTENDED TO PROVIDE LEGAL DIMENSIONS OR LOCATION OF PROPERTY OWNERSHIP LINES.