

FINAL PROOF SURVEY


IN THE NAME OF
DONALD C. JOHNSON

DATE 7/1/2002, SURVEYED BY J. LESTABROOK

TAX LOT NO. 1100 TAX MAP 23 12 8
SECTION 8 TOWNSHIP 23 SOUTH RANGE 12 WEST W.M.
COOS COUNTY, OREGON





SCALE 1" = 400'

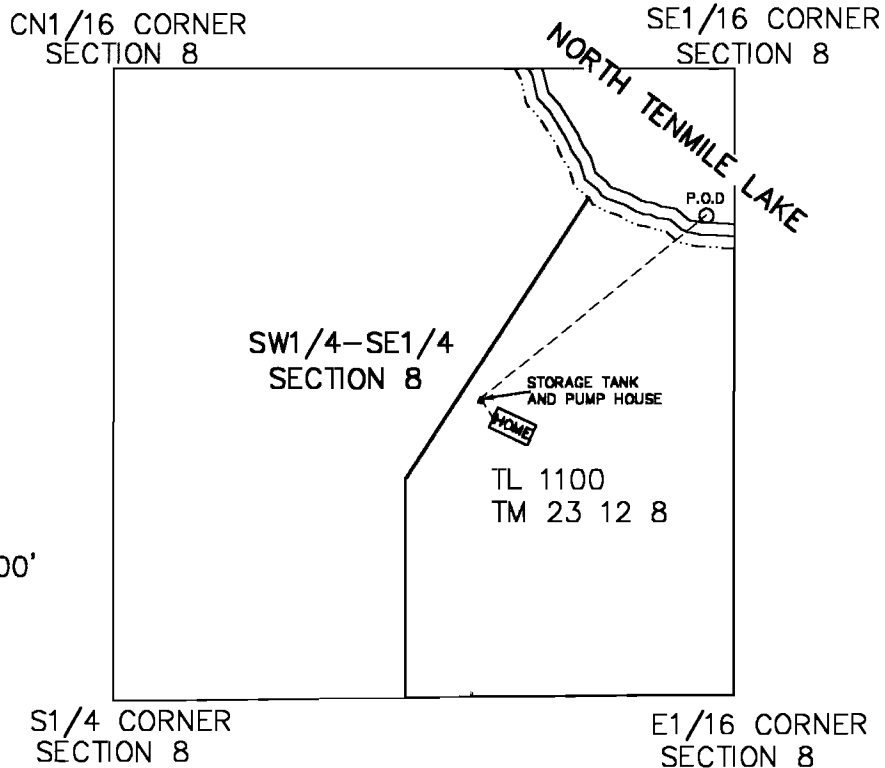

P.O.D. BEARS NORTH 51° EAST 1599' FROM THE SOUTH 1/4 CORNER OF SECTION 8

LEGEND

 -  POINT OF DIVERSION
-  HOME
-  STORAGE TANK AND PUMP HOUSE
-  TAX LOT
-  TAX MAP
-  DOMESTIC WATER LINE

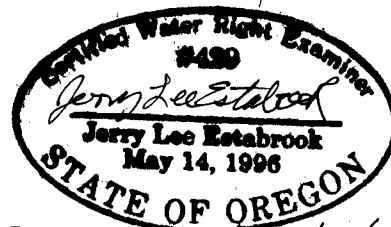

Renewal Date 12/31/03

RECEIVED

JUL 08 2002

EXAMINERS DISCLAIMER STATEMENT

THE PREPARATION OF THIS MAP WAS FOR THE PURPOSE OF IDENTIFYING THE LOCATION OF THE WATER RIGHT ONLY AND HAS NO INTENT TO PROVIDE DIMENSIONS OR LOCATION OF PROPERTY OWNERSHIP LINES.

WATER RESOURCES DEPT.
SALEM, OREGON

APPLICATION NO. S-83781
PERMIT NO. 53520