

FEB 28 2000

WATER RESOURCES DEPT
SALEM, OREGON

SECTION 27, T.2 N., R.4 W., W.M. WASHINGTON COUNTY, OREGON

MAP BASE:
7-20-98 SCALED PHOTO
ASSESSORS MAP

T.L. 402



SCALE: 1"=400'

2520'

1910'

PREPARATION OF THIS MAP IS FOR THE
PURPOSE OF IDENTIFYING THE LOCATION OF
THE WATER RIGHT ONLY. THERE IS NO INTENT
TO PROVIDE DIMENSIONS OR LOCATION OF
PROPERTY OWNERSHIP LINES.

POND #3

SEDIMENT
POND

POND #2

POND #1

2440'

2475'


1460'

1580'

1710'

1740'

N.W. KILIN ROAD

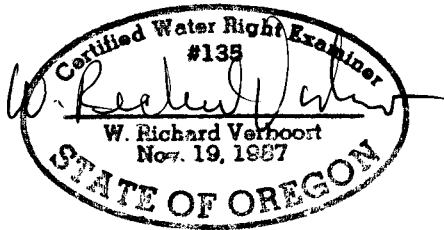

FINAL PROOF SURVEY

UNDER

APPLICATION PERMIT
S-74416 52264
R-74417 R-11800

SURVEYED FEBRUARY 12, 2000

28 27

33 34

N.W. NARUP ROAD

**DAVID A. and JUDITH R.
MADSEN**
14405 N.W. KILIN ROAD
BANKS, OR 97108

designed	by	date
drawn	by	date
checked	by	date
drawing no.	sheet no.	
02-A-01	1/1	

VERBOORT ENGINEERING
AGRICULTURE · CIVIL · WATER RESOURCES
HILLSBORO, OREGON