



Application No. R-74875
Permit No.

"CERTIFICATE NO. ~~10112~~

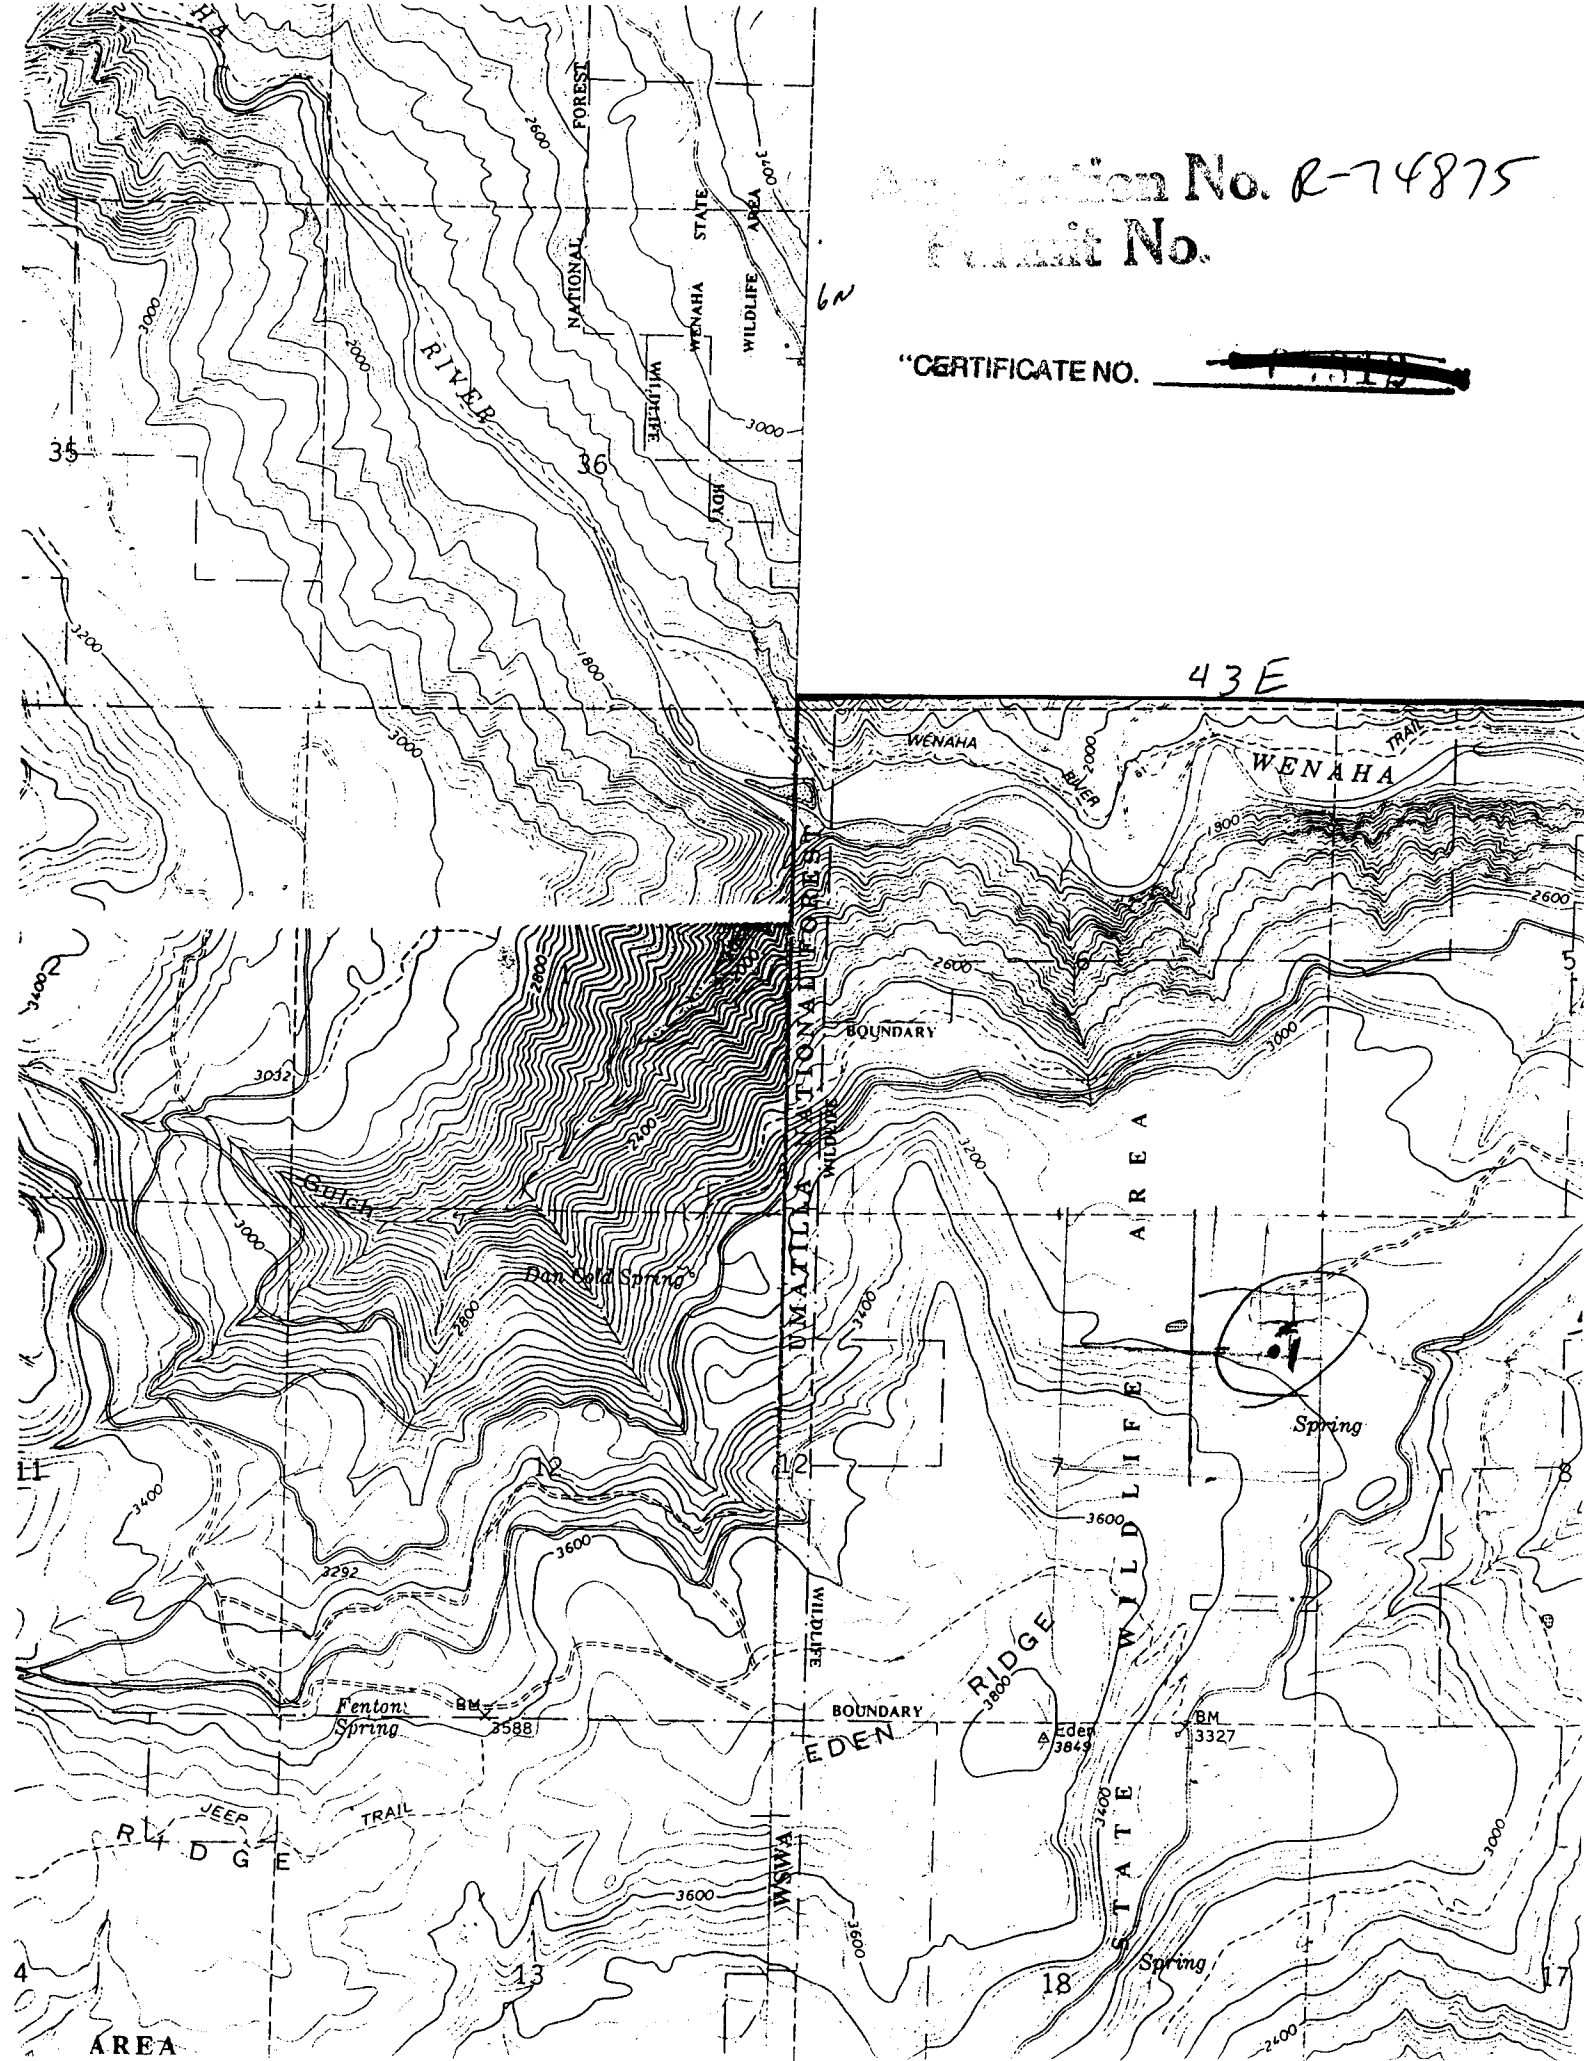

425

6 AL WRD

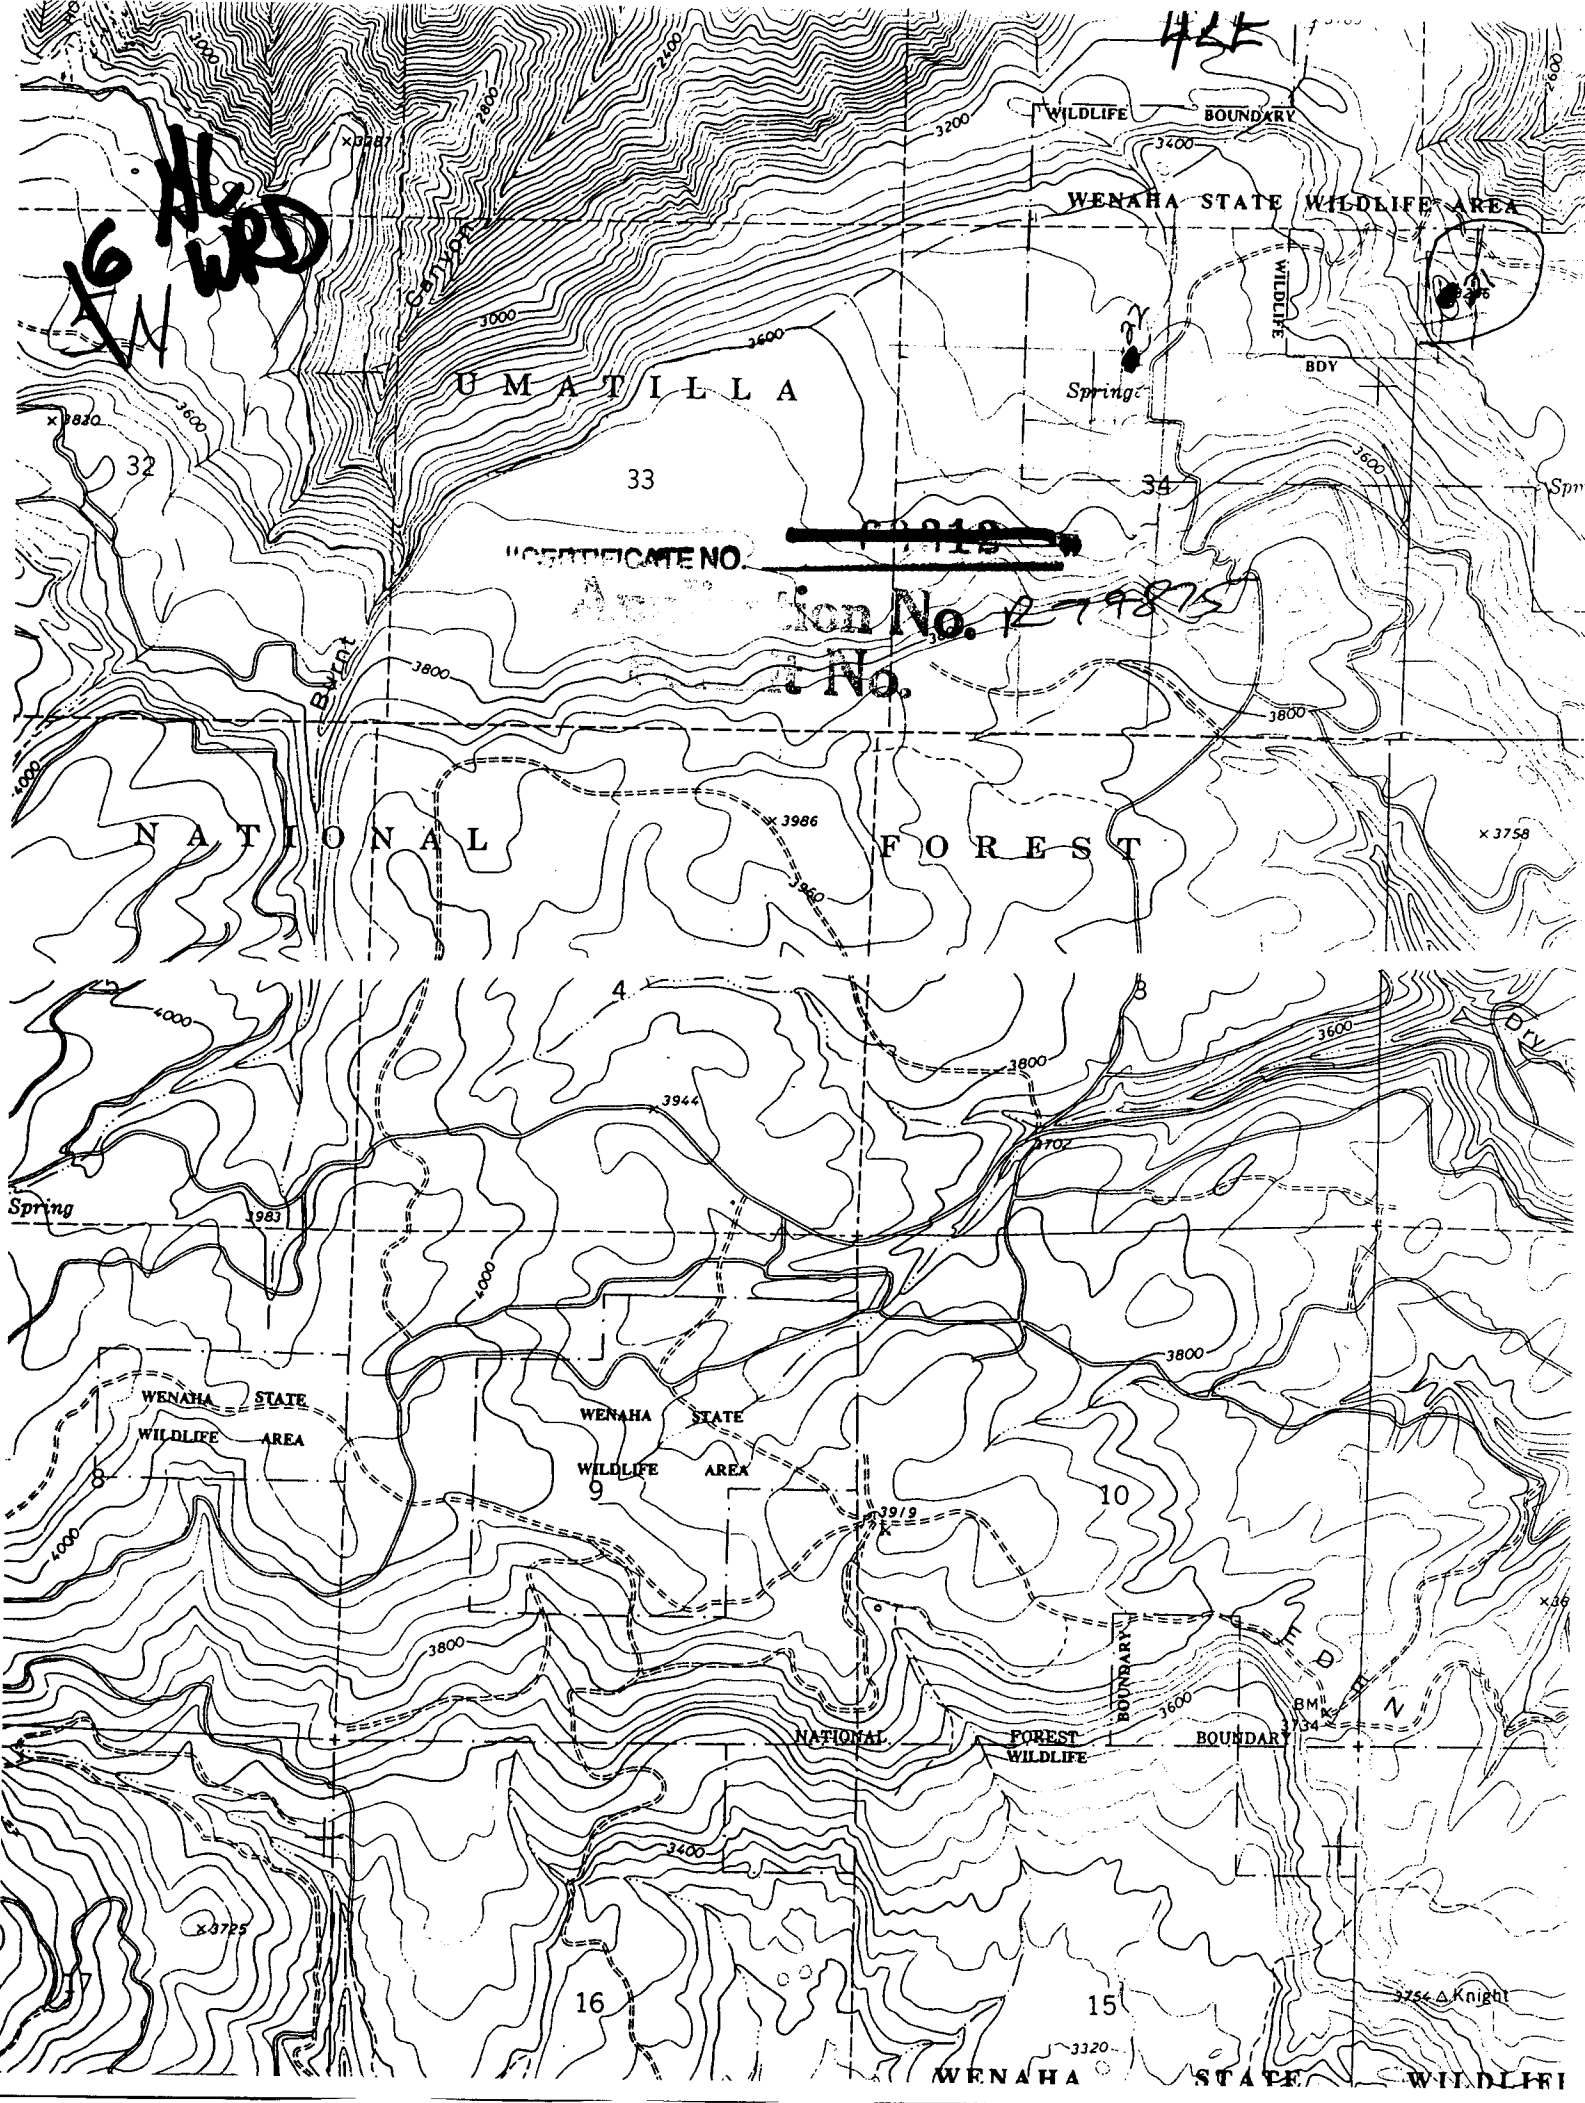

UMATILLA

WILDLIFE BOUNDARY
WENAH STATE WILDLIFE AREA

"CERTIFICATE NO.



NATIONAL FOREST

WENAH STATE WILDLIFE AREA


WENAH STATE WILDLIFE AREA

NATIONAL FOREST WILDLIFE BOUNDARY

WENAH STATE WILDLIFE

6 AC
N WRD

42E

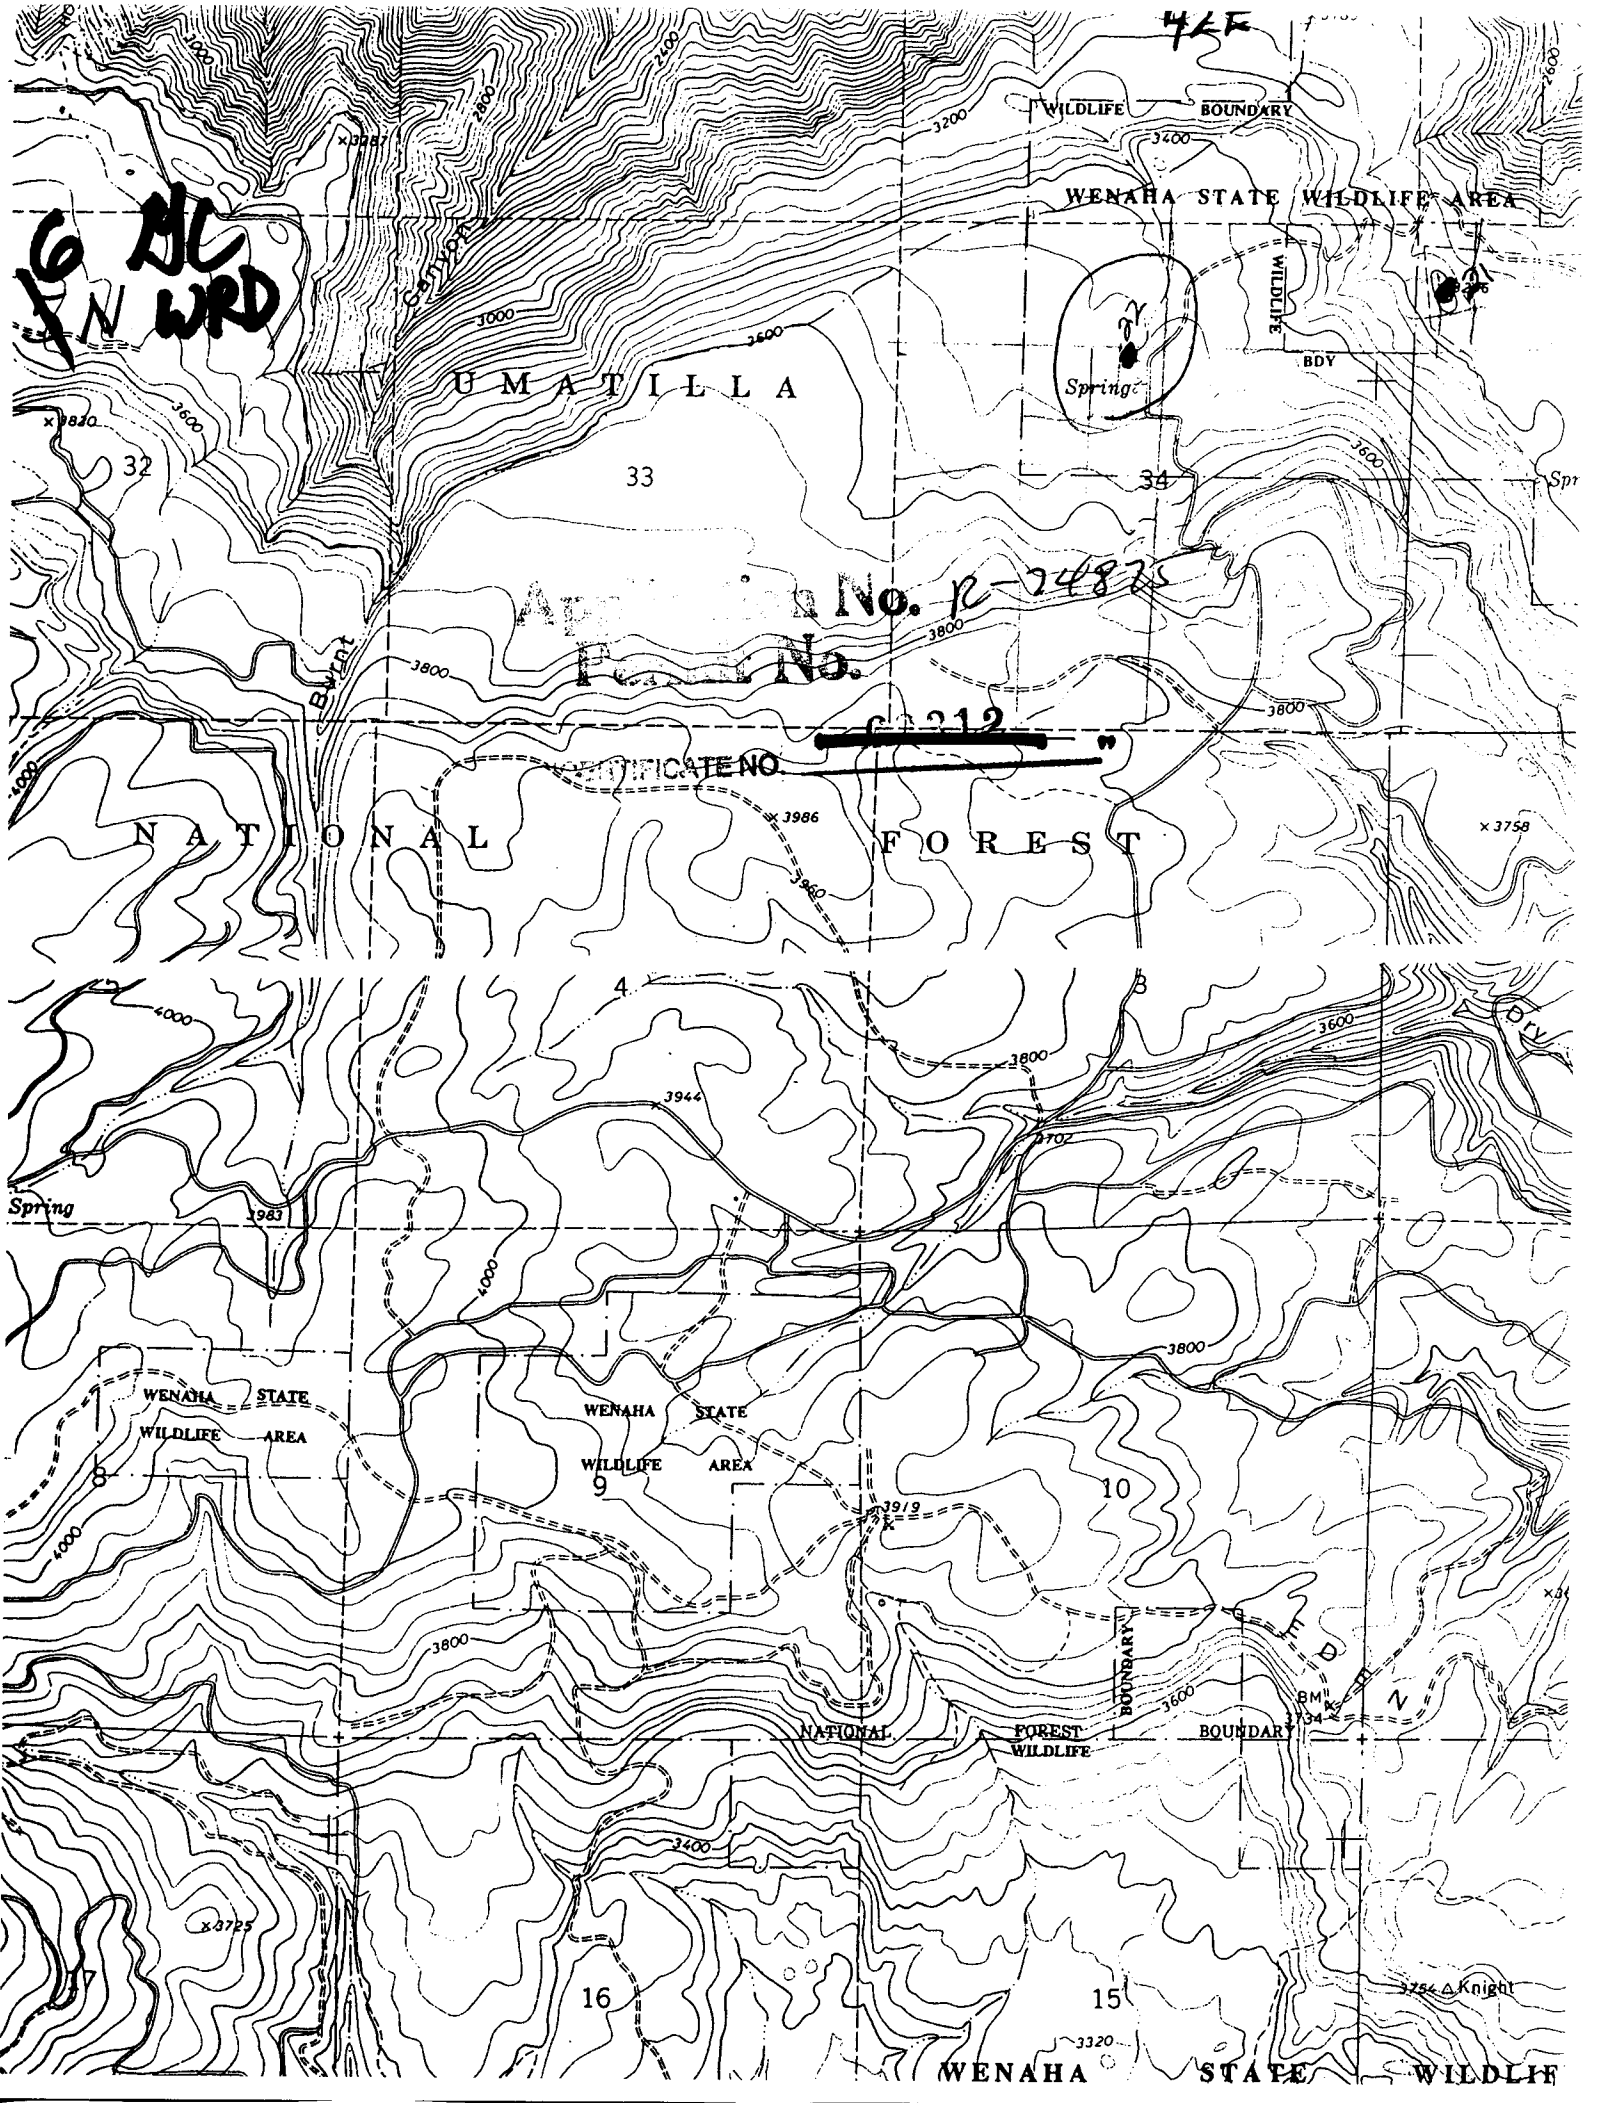

UMATILLA

Spring

No. R-24875

No.

212

CERTIFICATE NO.

NATIONAL

FOREST

WENAH STATE WILDLIFE AREA

WENAH STATE WILDLIFE AREA

NATIONAL

FOREST WILDLIFE

BOUNDARY

WENAH STATE WILDLIFE