


FINAL PROOF SURVEY MAP
 IN THE NAME OF PAUL L. SANTOS
 APPLICATION S-72232 PERMIT 52274
 SECTION 14, TOWNSHIP 26 SOUTH, RANGE 4 WEST, W.M.

RECEIVED

SEP 07 1999

WATER RESOURCES DEPT.
 SALEM, OREGON

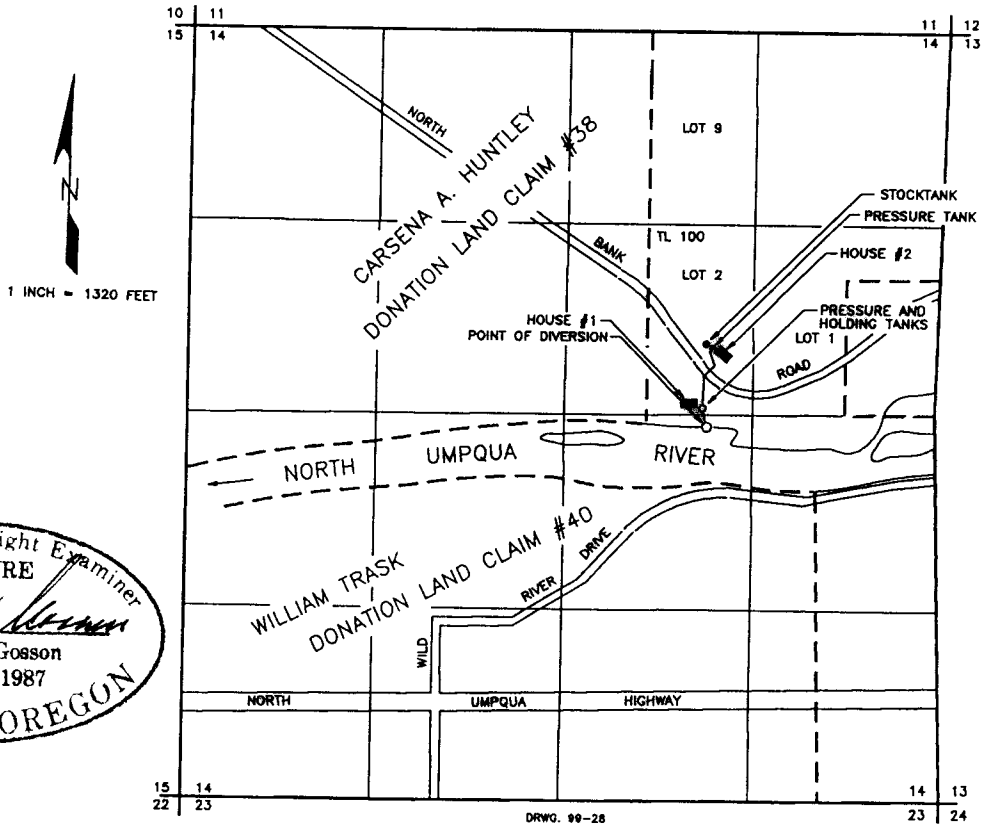

Certified Water Right Examiner
 #054 WRE
James F. Gosson
 James F. Gosson
 Nov. 19, 1987
 STATE OF OREGON

THE POINT OF DIVERSION IS LOCATED 2720 FEET SOUTH AND 1550 FEET WEST FROM THE NORTHEAST CORNER OF SECTION 14, BEING WITHIN THE NW 1/4 SE 1/4, SECTION 14, TOWNSHIP 26 SOUTH, RANGE 4 WEST, W.M., DOUGLAS COUNTY.

THE PURPOSE OF THIS MAP IS TO IDENTIFY THE LOCATION OF THE WATER RIGHT. IT IS NOT INTENDED TO PROVIDE INFORMATION RELATIVE TO THE LOCATION OF PROPERTY OWNERSHIP BOUNDARY LINES.