



SECTION 10

Oregon State Water Filings

TOWNSHIP 10S, RANGE 42E, W. M.

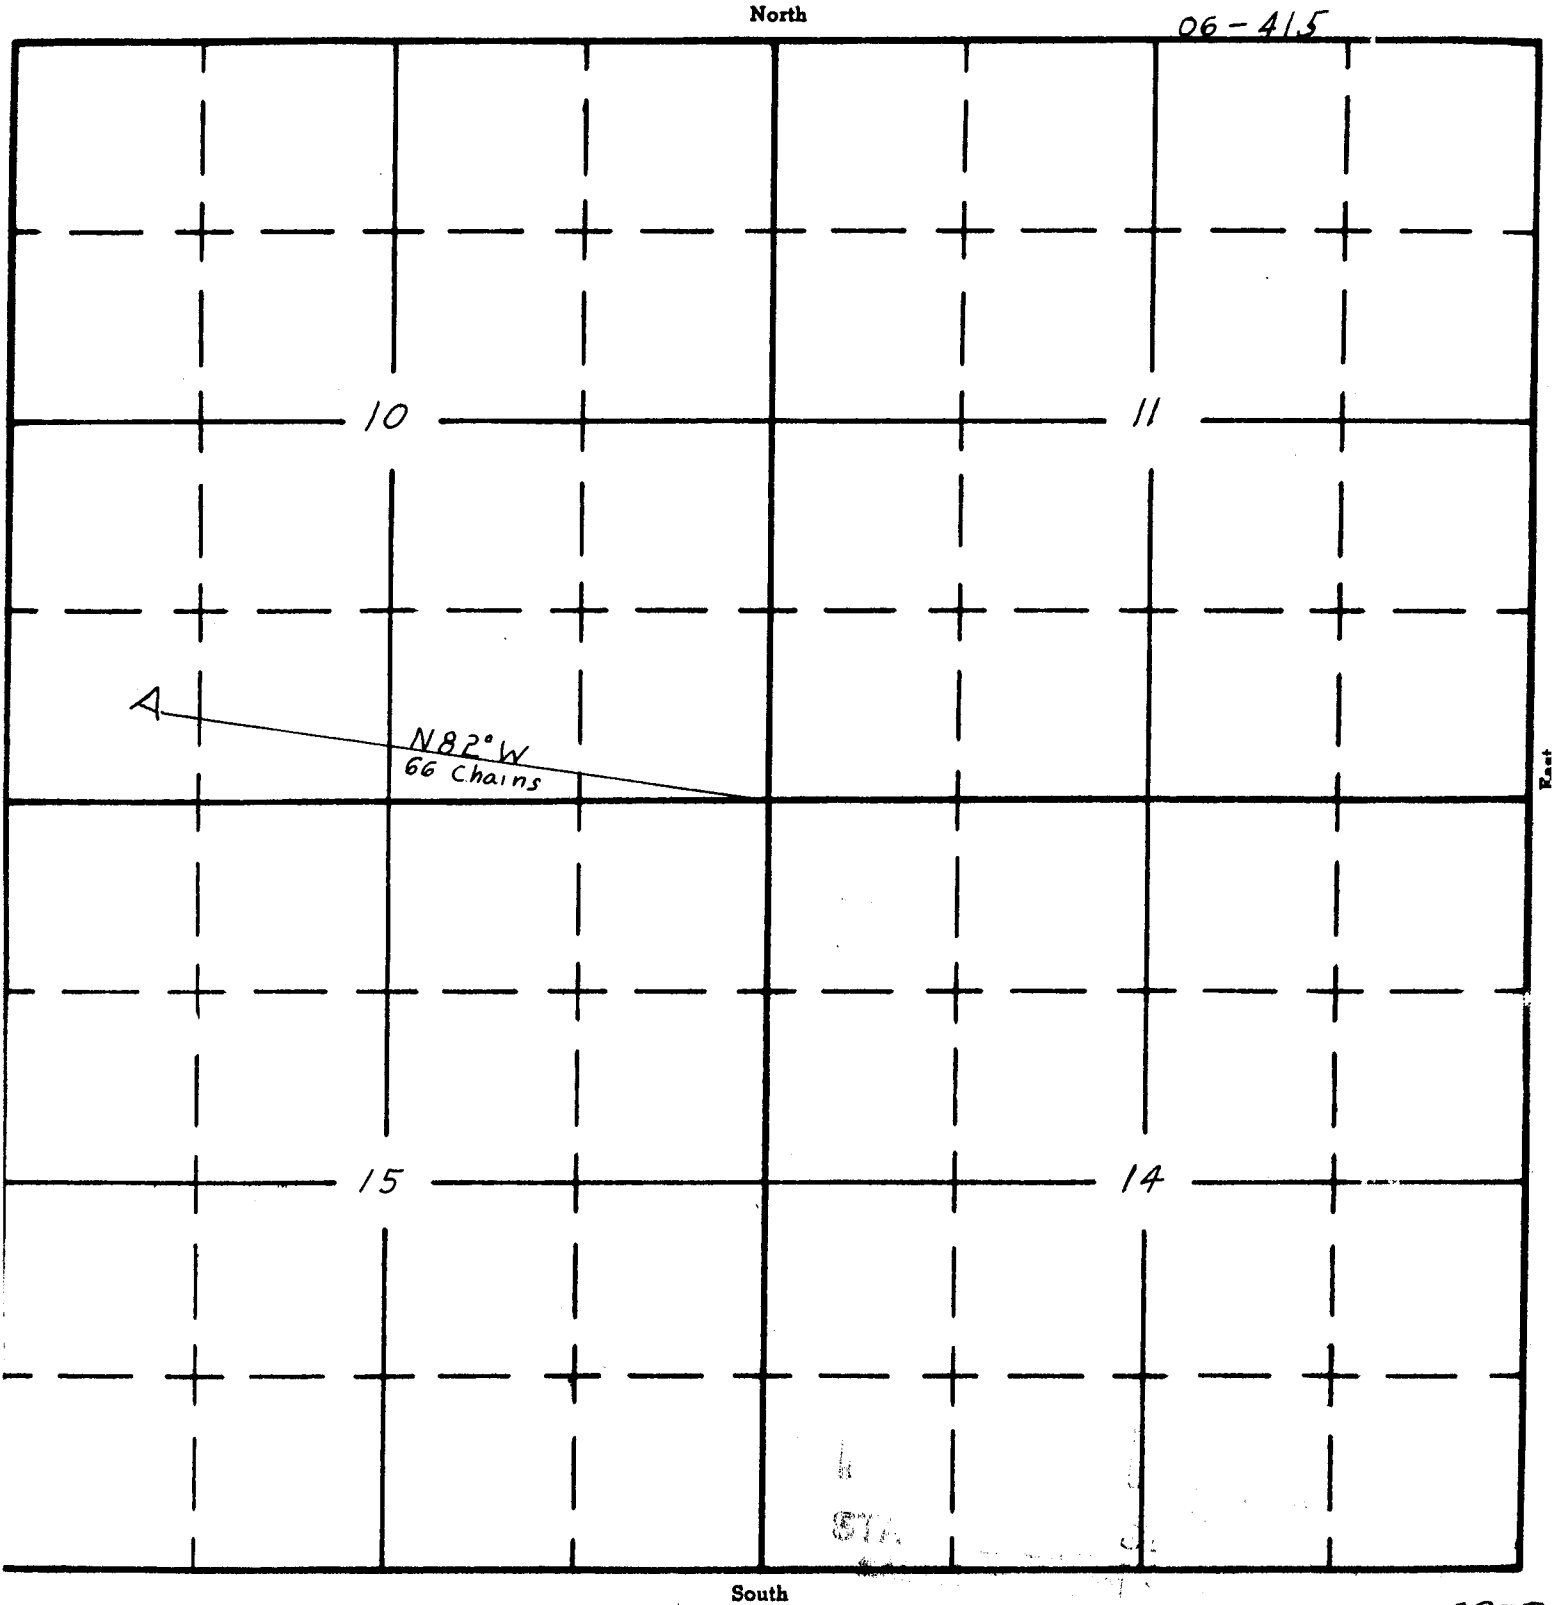

South

APPLICATION No. R-3873
PERMIT No. R-3286