

UNITED STATES
DEPARTMENT OF THE INTERIOR
BUREAU OF LAND MANAGEMENT

SECTION


24

Oregon State Water Filings

TOWNSHIP 10S, RANGE 42E, W. M.

North

06-409

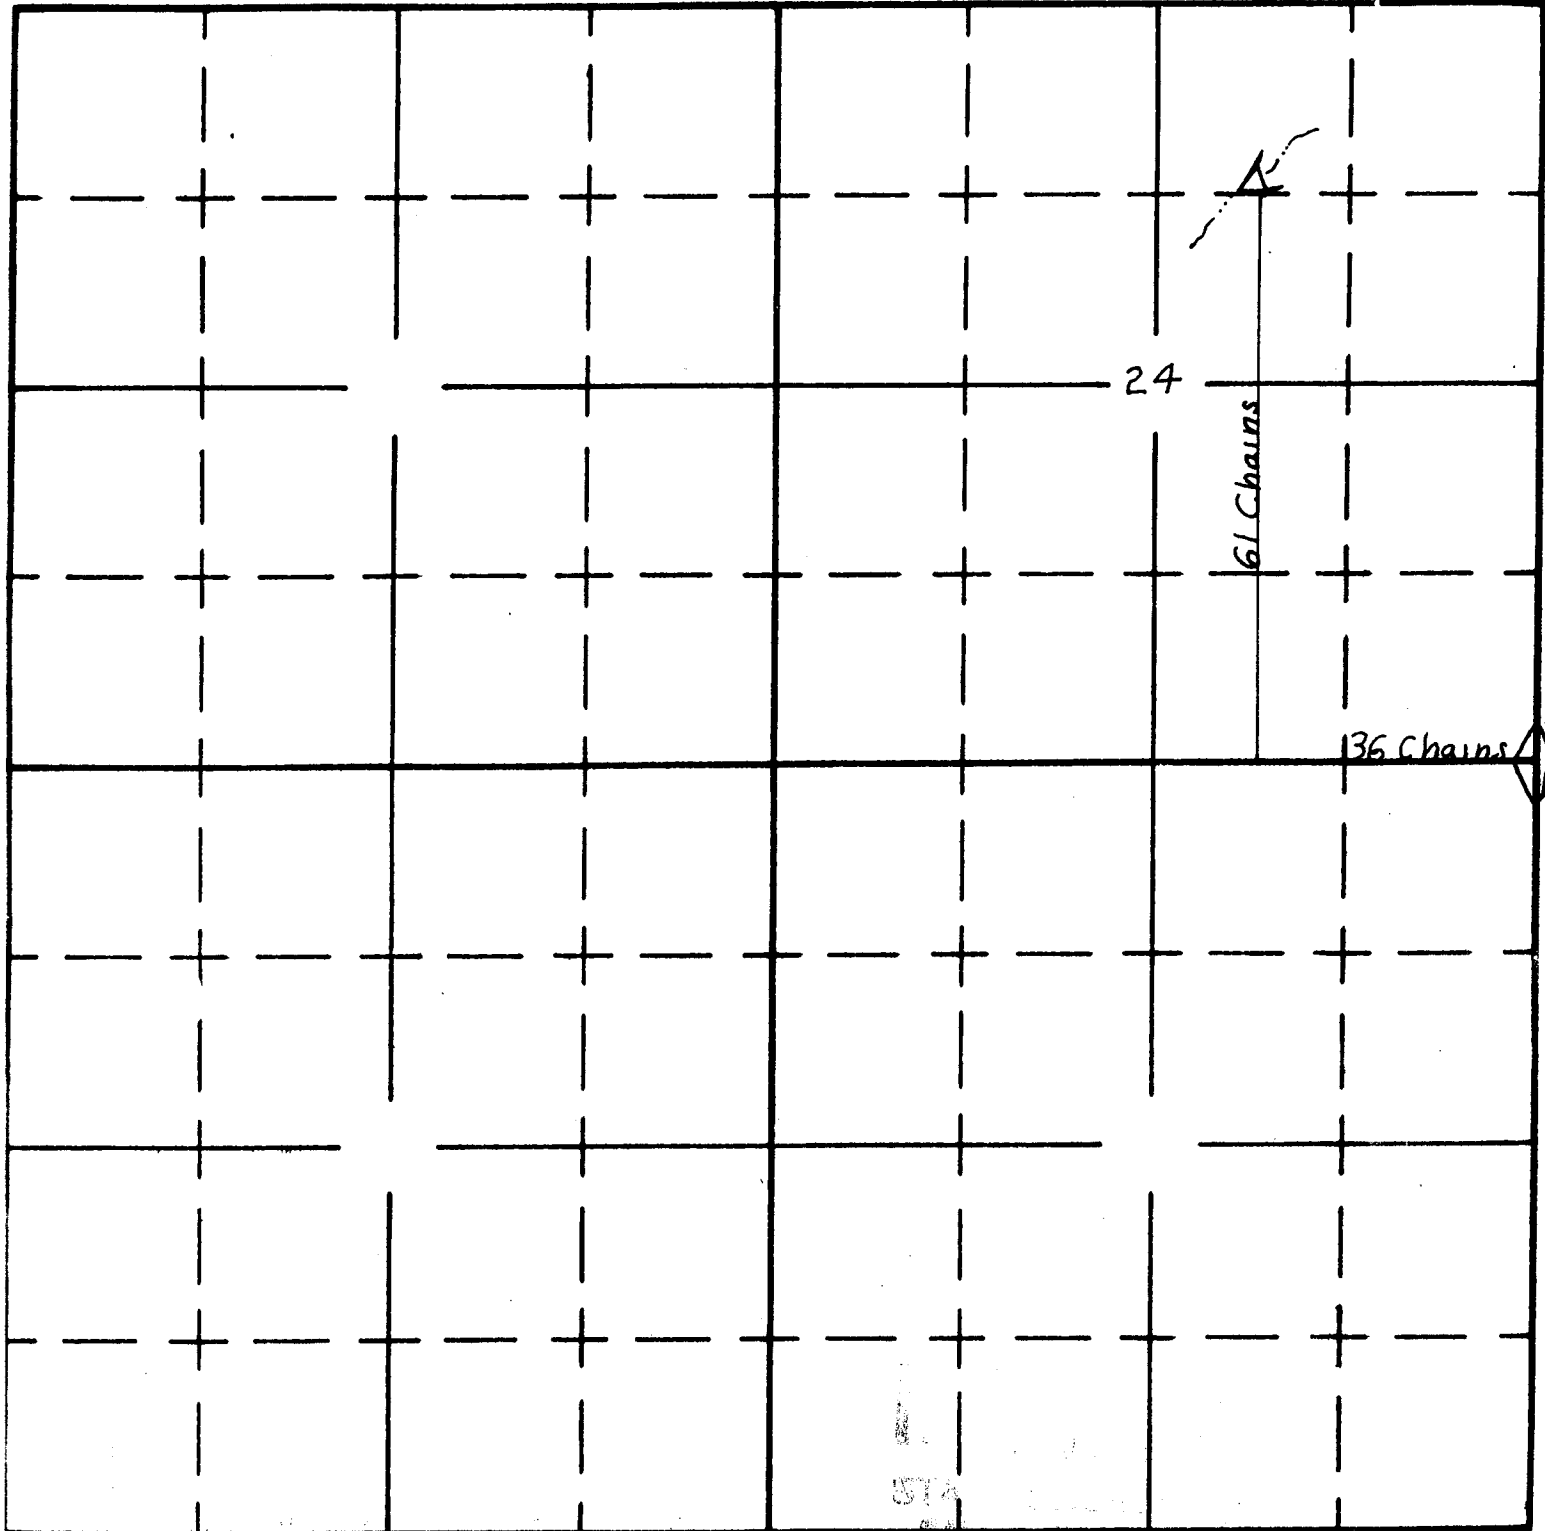

South

APPLICATION No. R-38731

PERMIT No. R-3283