

Form A1-187
March 1961

UNITED STATES
DEPARTMENT OF THE INTERIOR
BUREAU OF LAND MANAGEMENT

SECTION


35

Oregon State Water Filings

TOWNSHIP 10S, RANGE 42E, W. M.

North

06-333

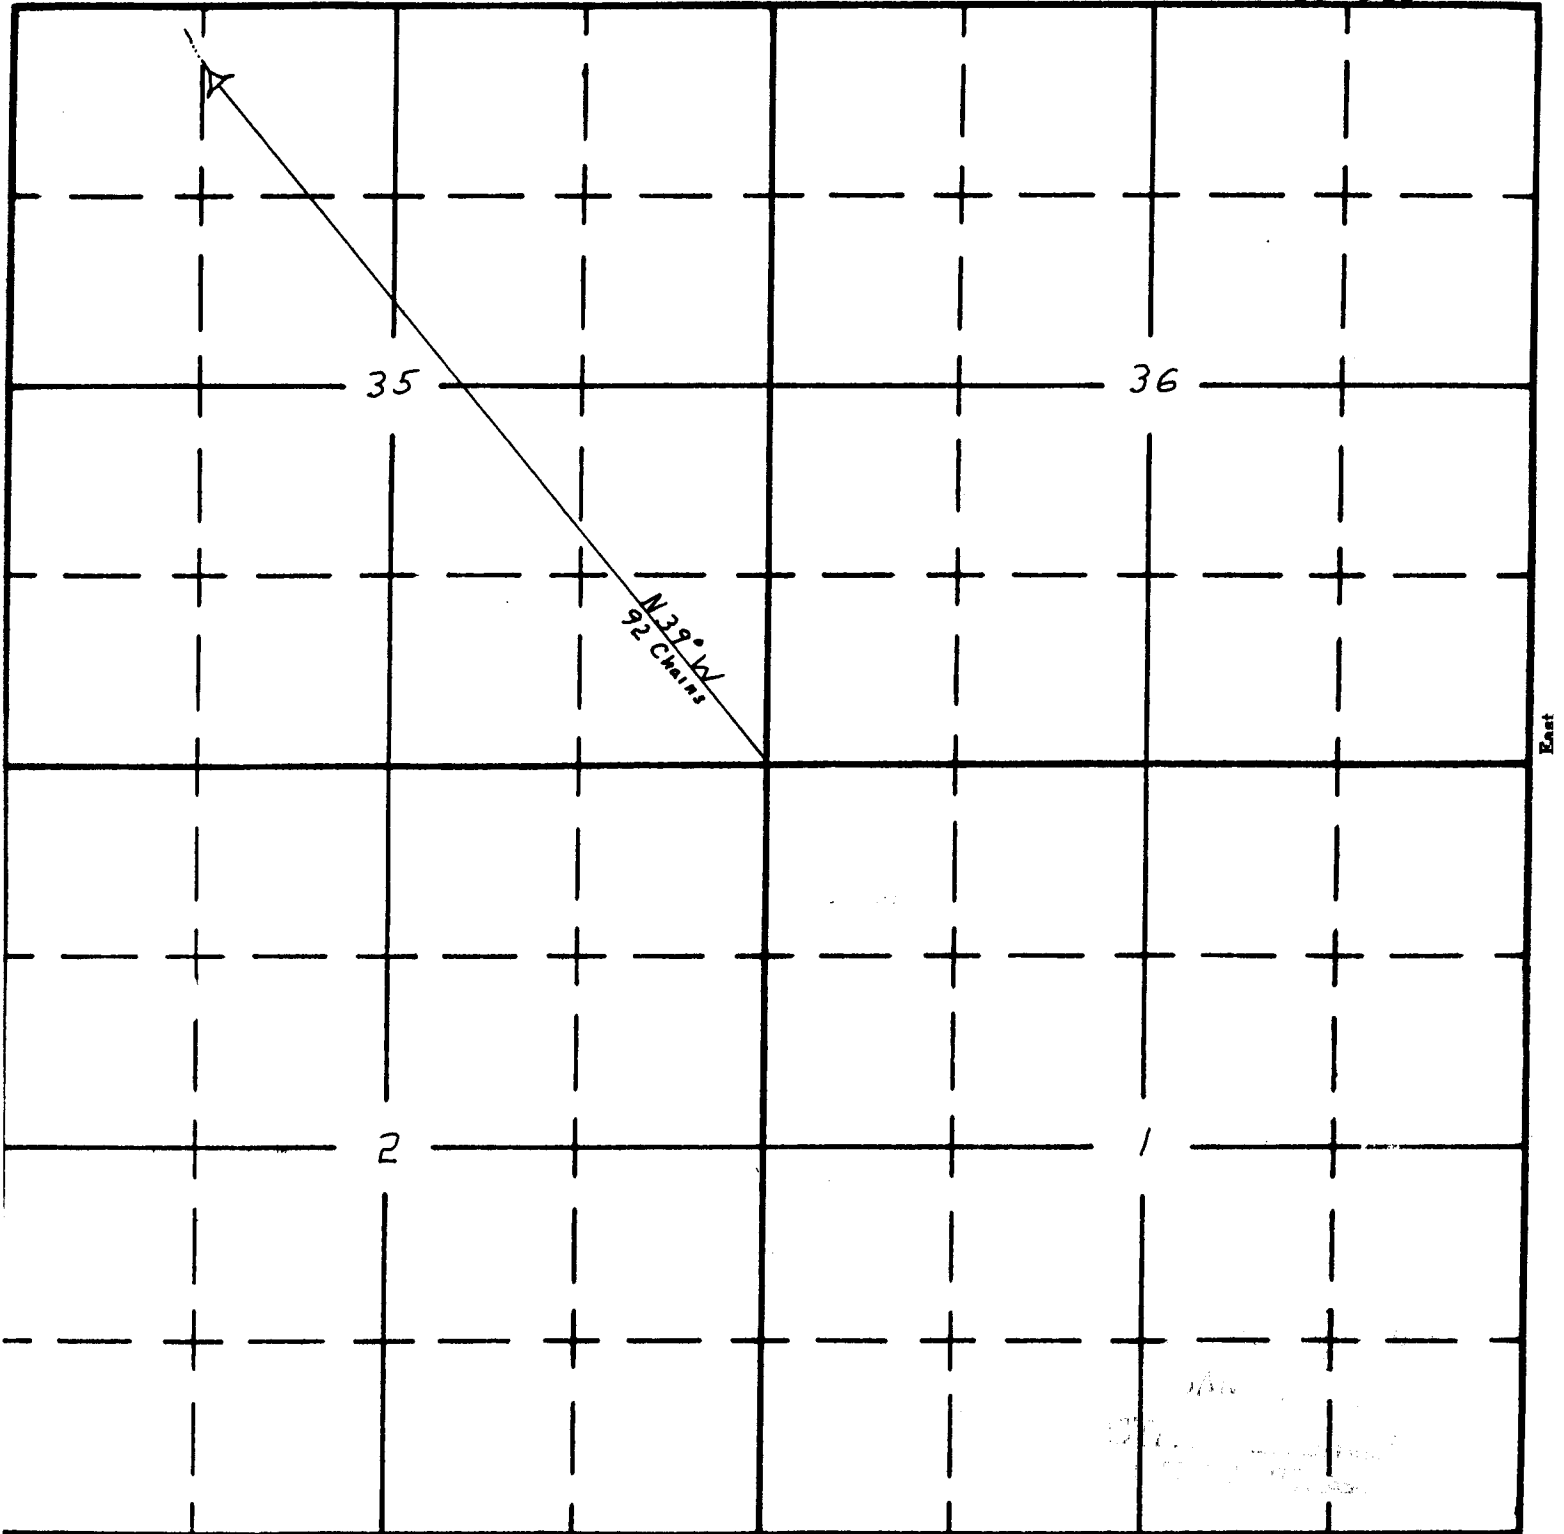

South

APPLICATION No. R-38396
PERMIT No. R-3853