

Form A1-187
March 1961


UNITED STATES
DEPARTMENT OF THE INTERIOR
BUREAU OF LAND MANAGEMENT

SECTION

27

Oregon State Water Filings

TOWNSHIP 10S, RANGE 42E, W. M.

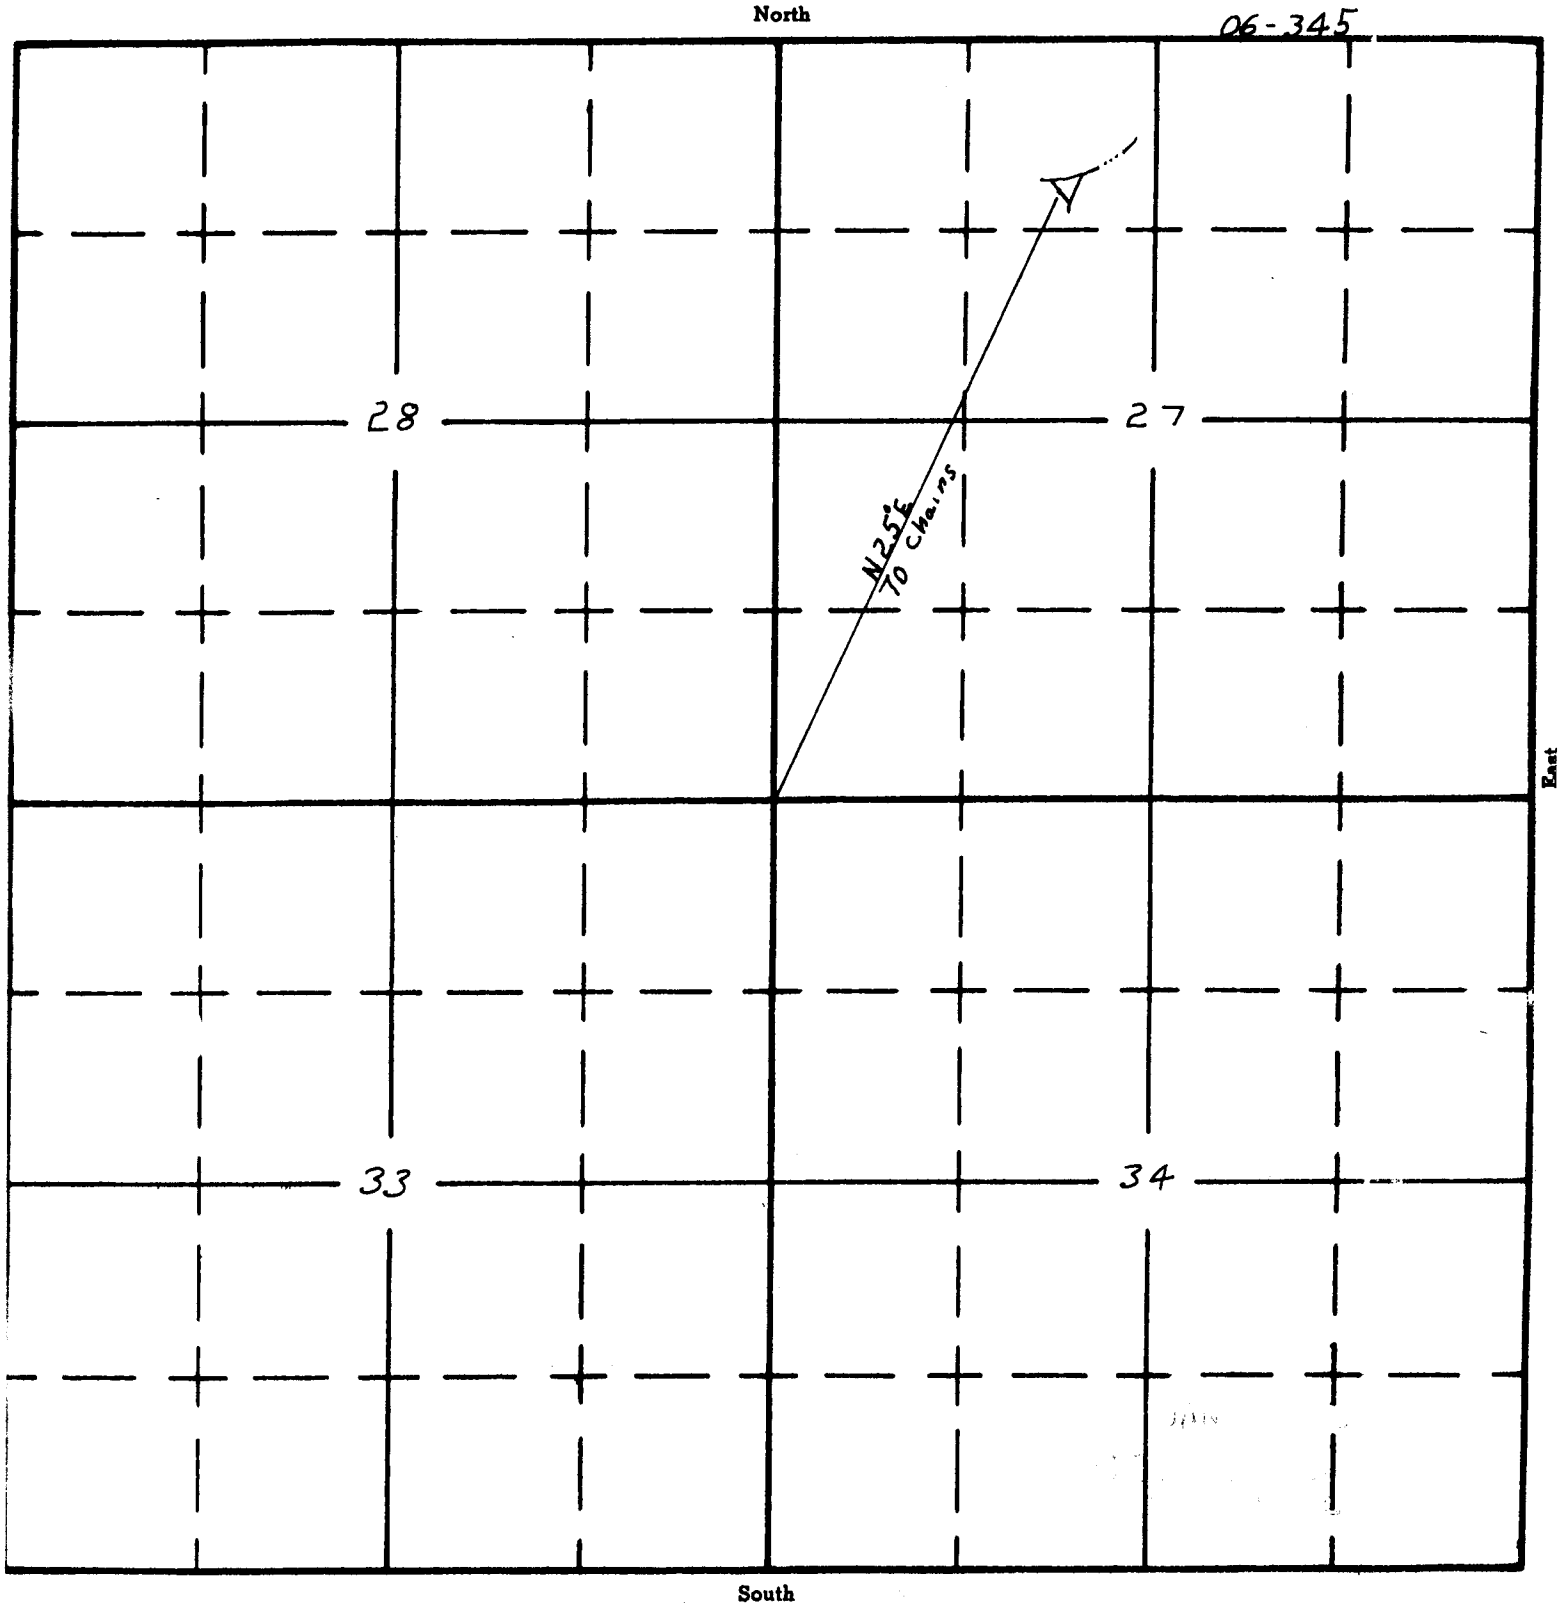

APPLICATION No. R-3840
PERMIT No. R-3855