

UNITED STATES
DEPARTMENT OF THE INTERIOR
BUREAU OF LAND MANAGEMENT

SECTION


14

Oregon State Water Filings

TOWNSHIP 10S, RANGE 42E, W. M.

North

06-352

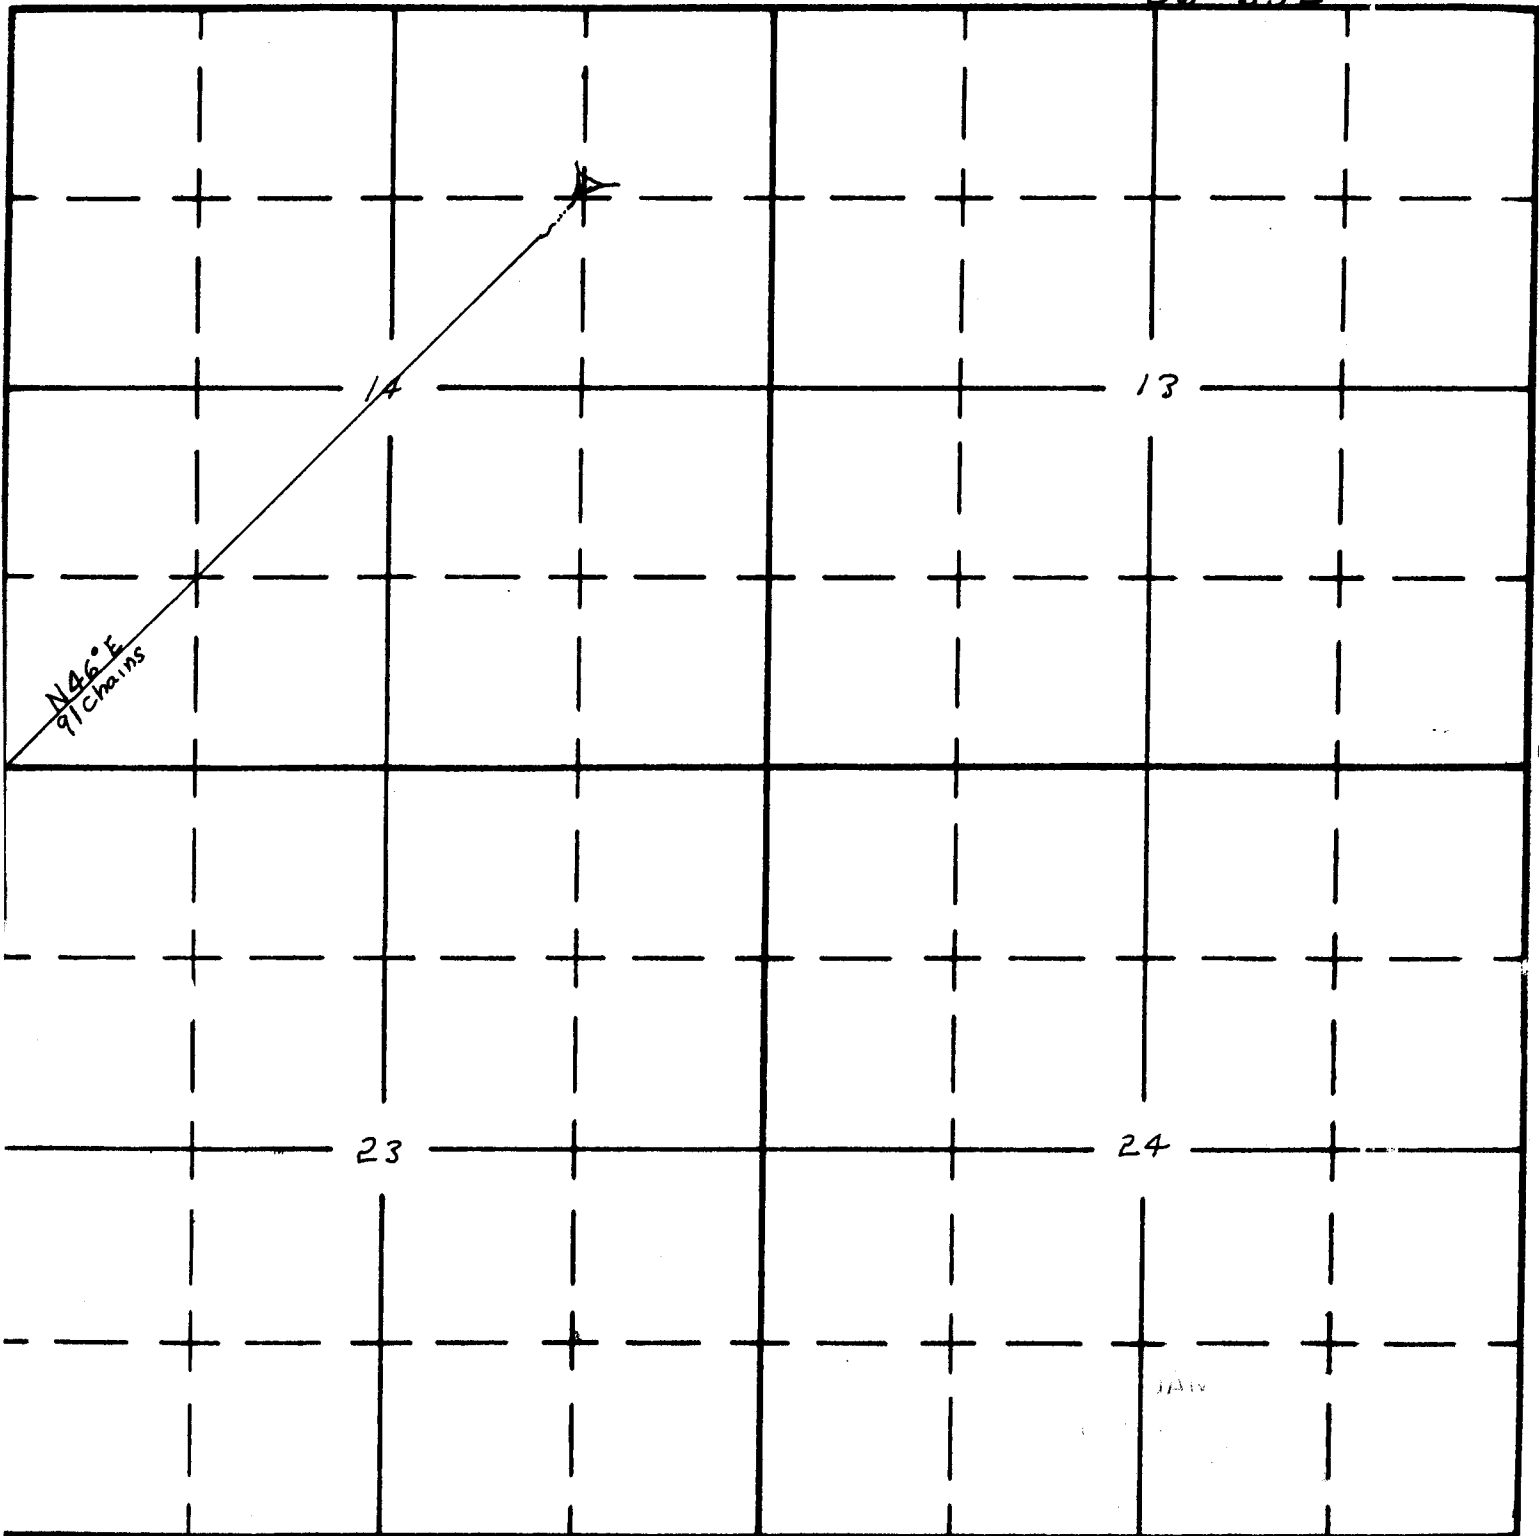

South

APPLICATION No. A-38406
0-2960