


SECTION

5
NE 1/4 SW 1/4

TOWNSHIP 41S, RANGE 4E, W. M.

North

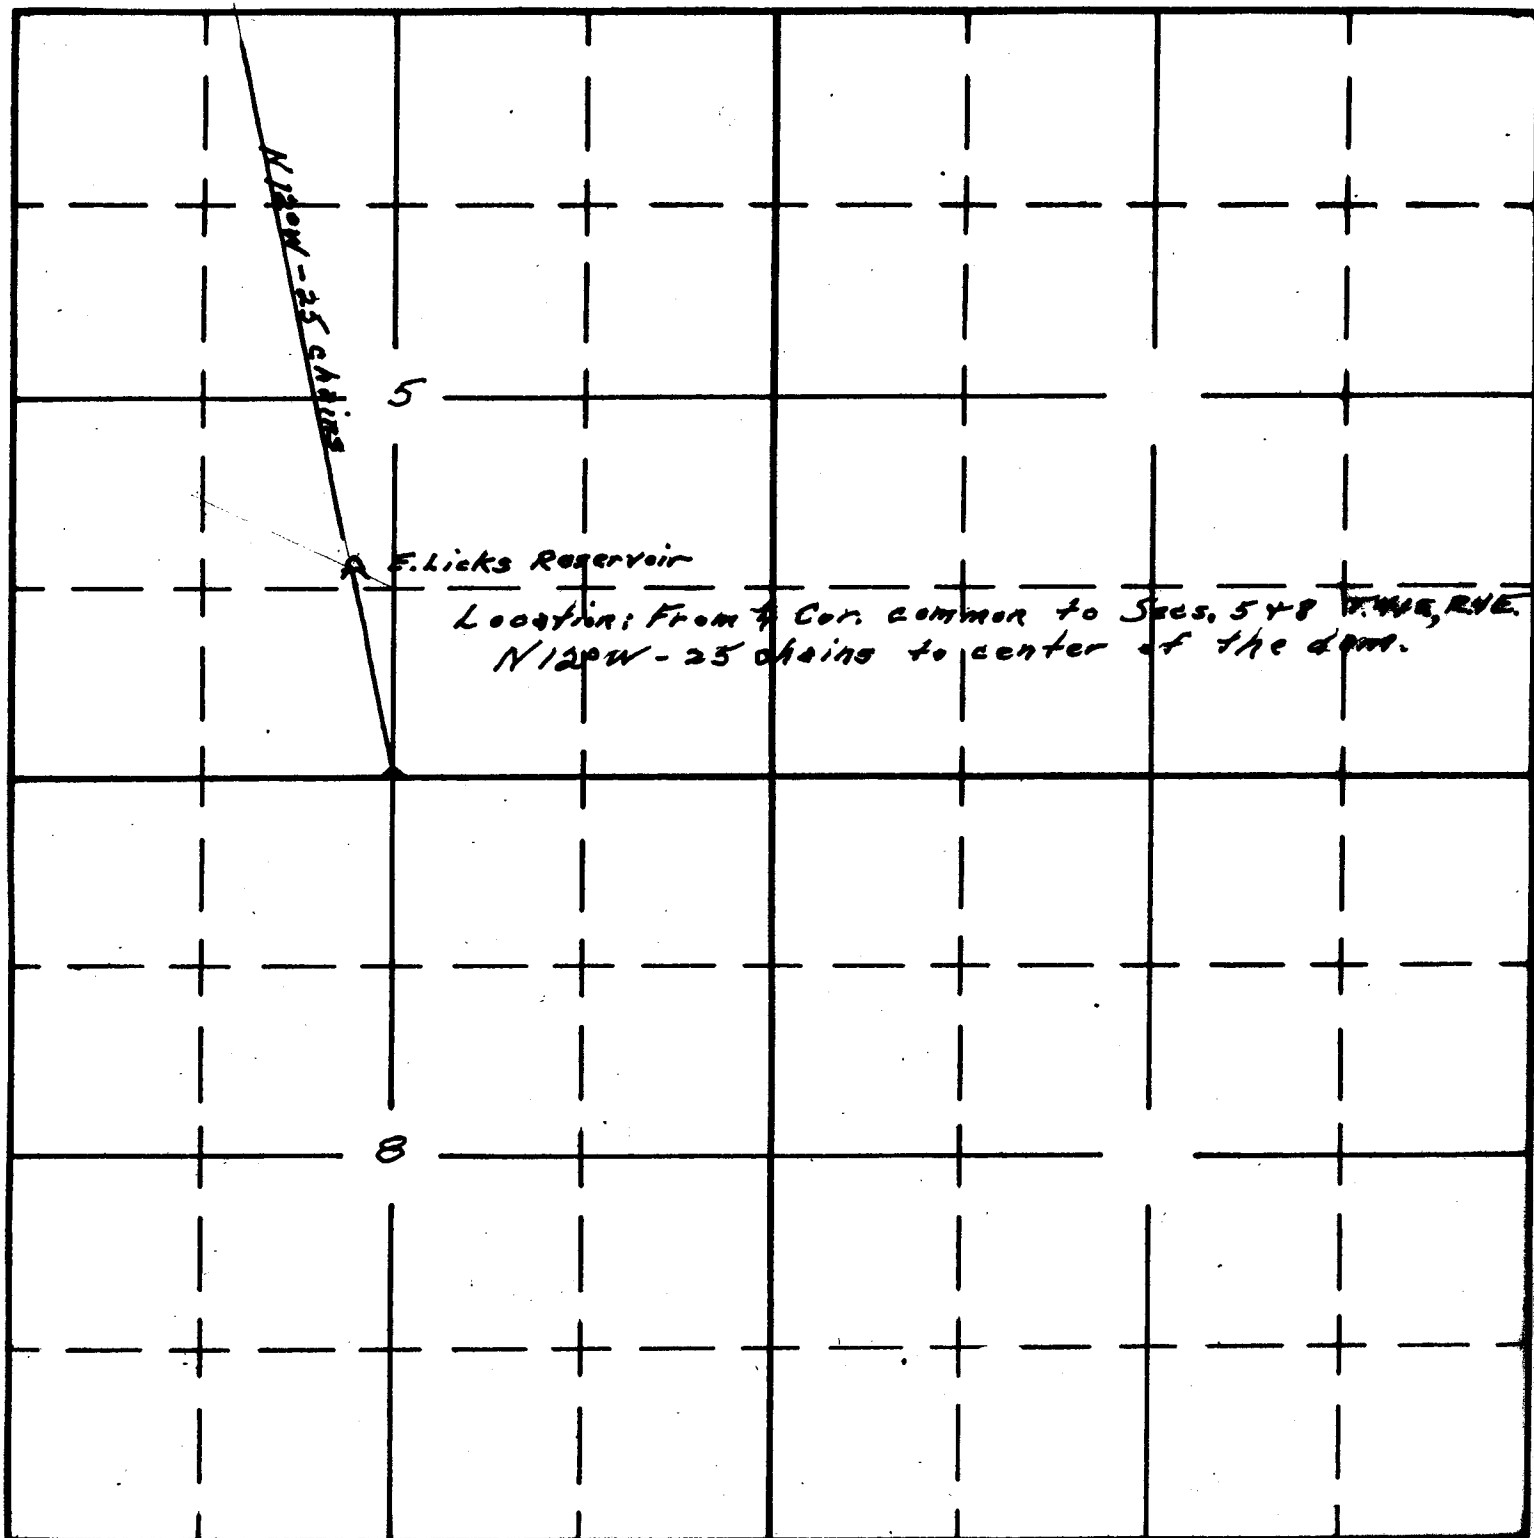

South

REGISTERED
DEC 22 1960
STATE ENGINEER
DALE H. HARRIS

Application No. R-34192
Permit No. R-4148