


North Fork Reservoir

Sec. 19 T.40S., R.4E.

Scale 4" = 1 mile

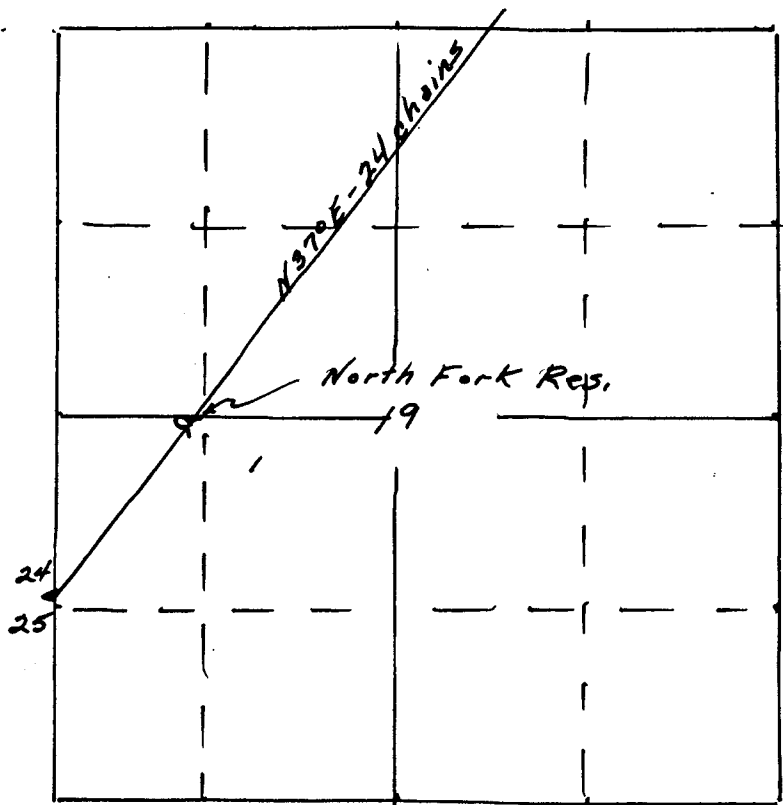

Location: From the corner of Sec 24 and 25 T.40S R.4E

N37°E-24 chains to the center of the dam. Reservoir

in the NW 1/4 SW 1/4 Sec. 19 T.40S, R.4E.

Application No. R-34193

Permit No. R-4149