


FINAL PROOF SURVEY AND CLAIM OF BENEFICIAL USE

RESERVOIR LOCATED WITHIN
NE 1/4, NE 1/4, SECTION 10 AND NW 1/4, NW 1/4
SECTION 11, T.1S., R.35E., W.M.,
UMATILLA COUNTY, OREGON

APPLICANT: PENDLETON RANCHES INC.
APPLICATION R-71952


PERMIT R-12451

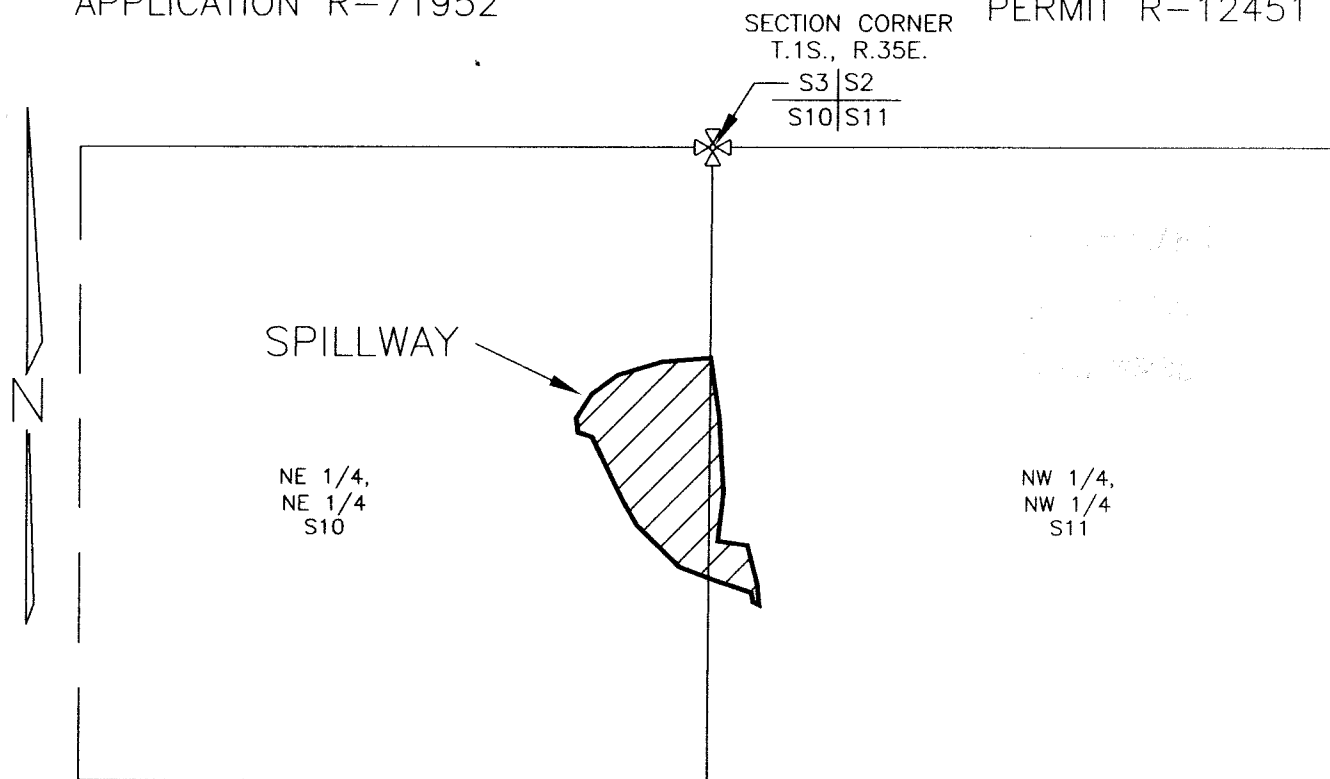

LEGEND

SECTION LINE

1/16TH SECTION LINE

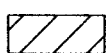


AREA SUBMERGED, 2.33 ACRES.
1.95 ACRES WITHIN NE 1/4, NE 1/4,
SECTION 10 AND 0.38 ACRE WITHIN
NW 1/4, NW 1/4, SECTION 11

CORNER TIE:
CENTER OF SPILLWAY IS
540 FEET SOUTH AND 270
FEET WEST OF NORTHEAST
CORNER OF SECTION 10
T.1S., R.35E., W.M.

400' 0' 400'
1"=400'

THIS MAP IS PREPARED
FOR THE EXPRESS
PURPOSE TO SHOW WATER
APPROPRIATION AND USE.
IT IS NOT INTENDED TO
SHOW OR LOCATE
PROPERTY OWNERSHIP
LINES.

©

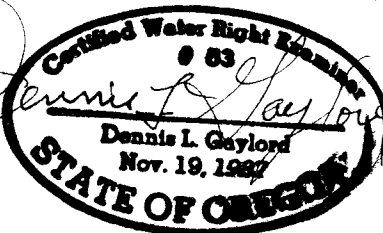

Renews 6/30/2003

DENNIS L. GAYLORD,
CWRE
71614 S.W. LAKE DRIVE
PENDLETON, OR 97801
(541)-276-6260
JULY, 2002

Mill Creek Drafting