1

NW¼ NW¼ Sec 1

T44S, R3E. TOWNSHIP 44S, RANGE 3E, W. M.

35 36

North

Cooks Camp Reservoir

From the corner common to Sec. 35 + 36 T44S R31 South 50°W 2 chains to the center of the dam. Dam in the NW¼NW¼ Sec 1

1

East

South

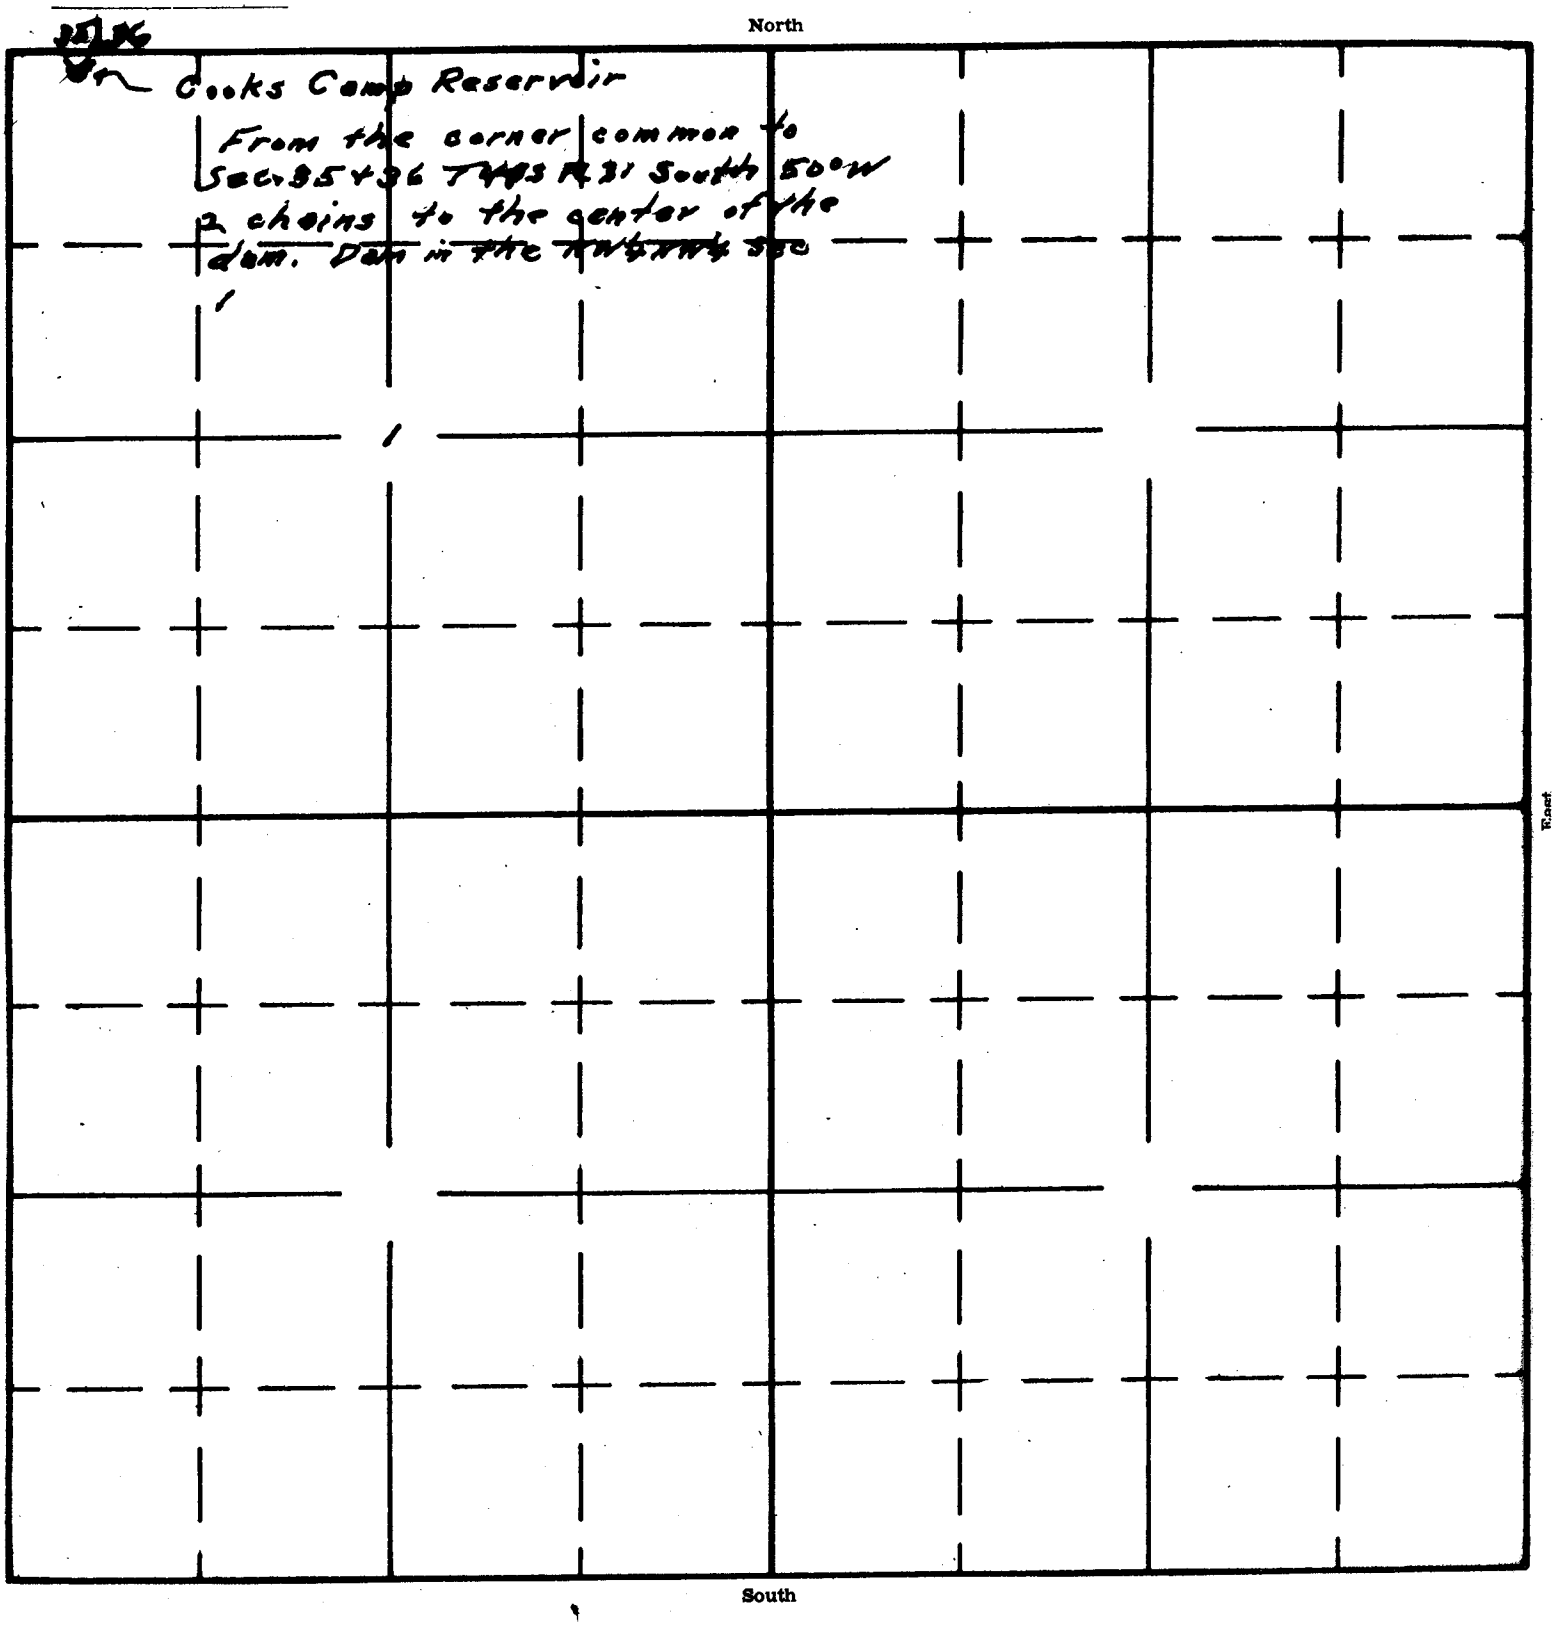

Application No. R-34249

Permit No. R-4153