


Section No. R-51477

T1G5 R24E Sec. 10

Permit No. R-7590 - 3rd

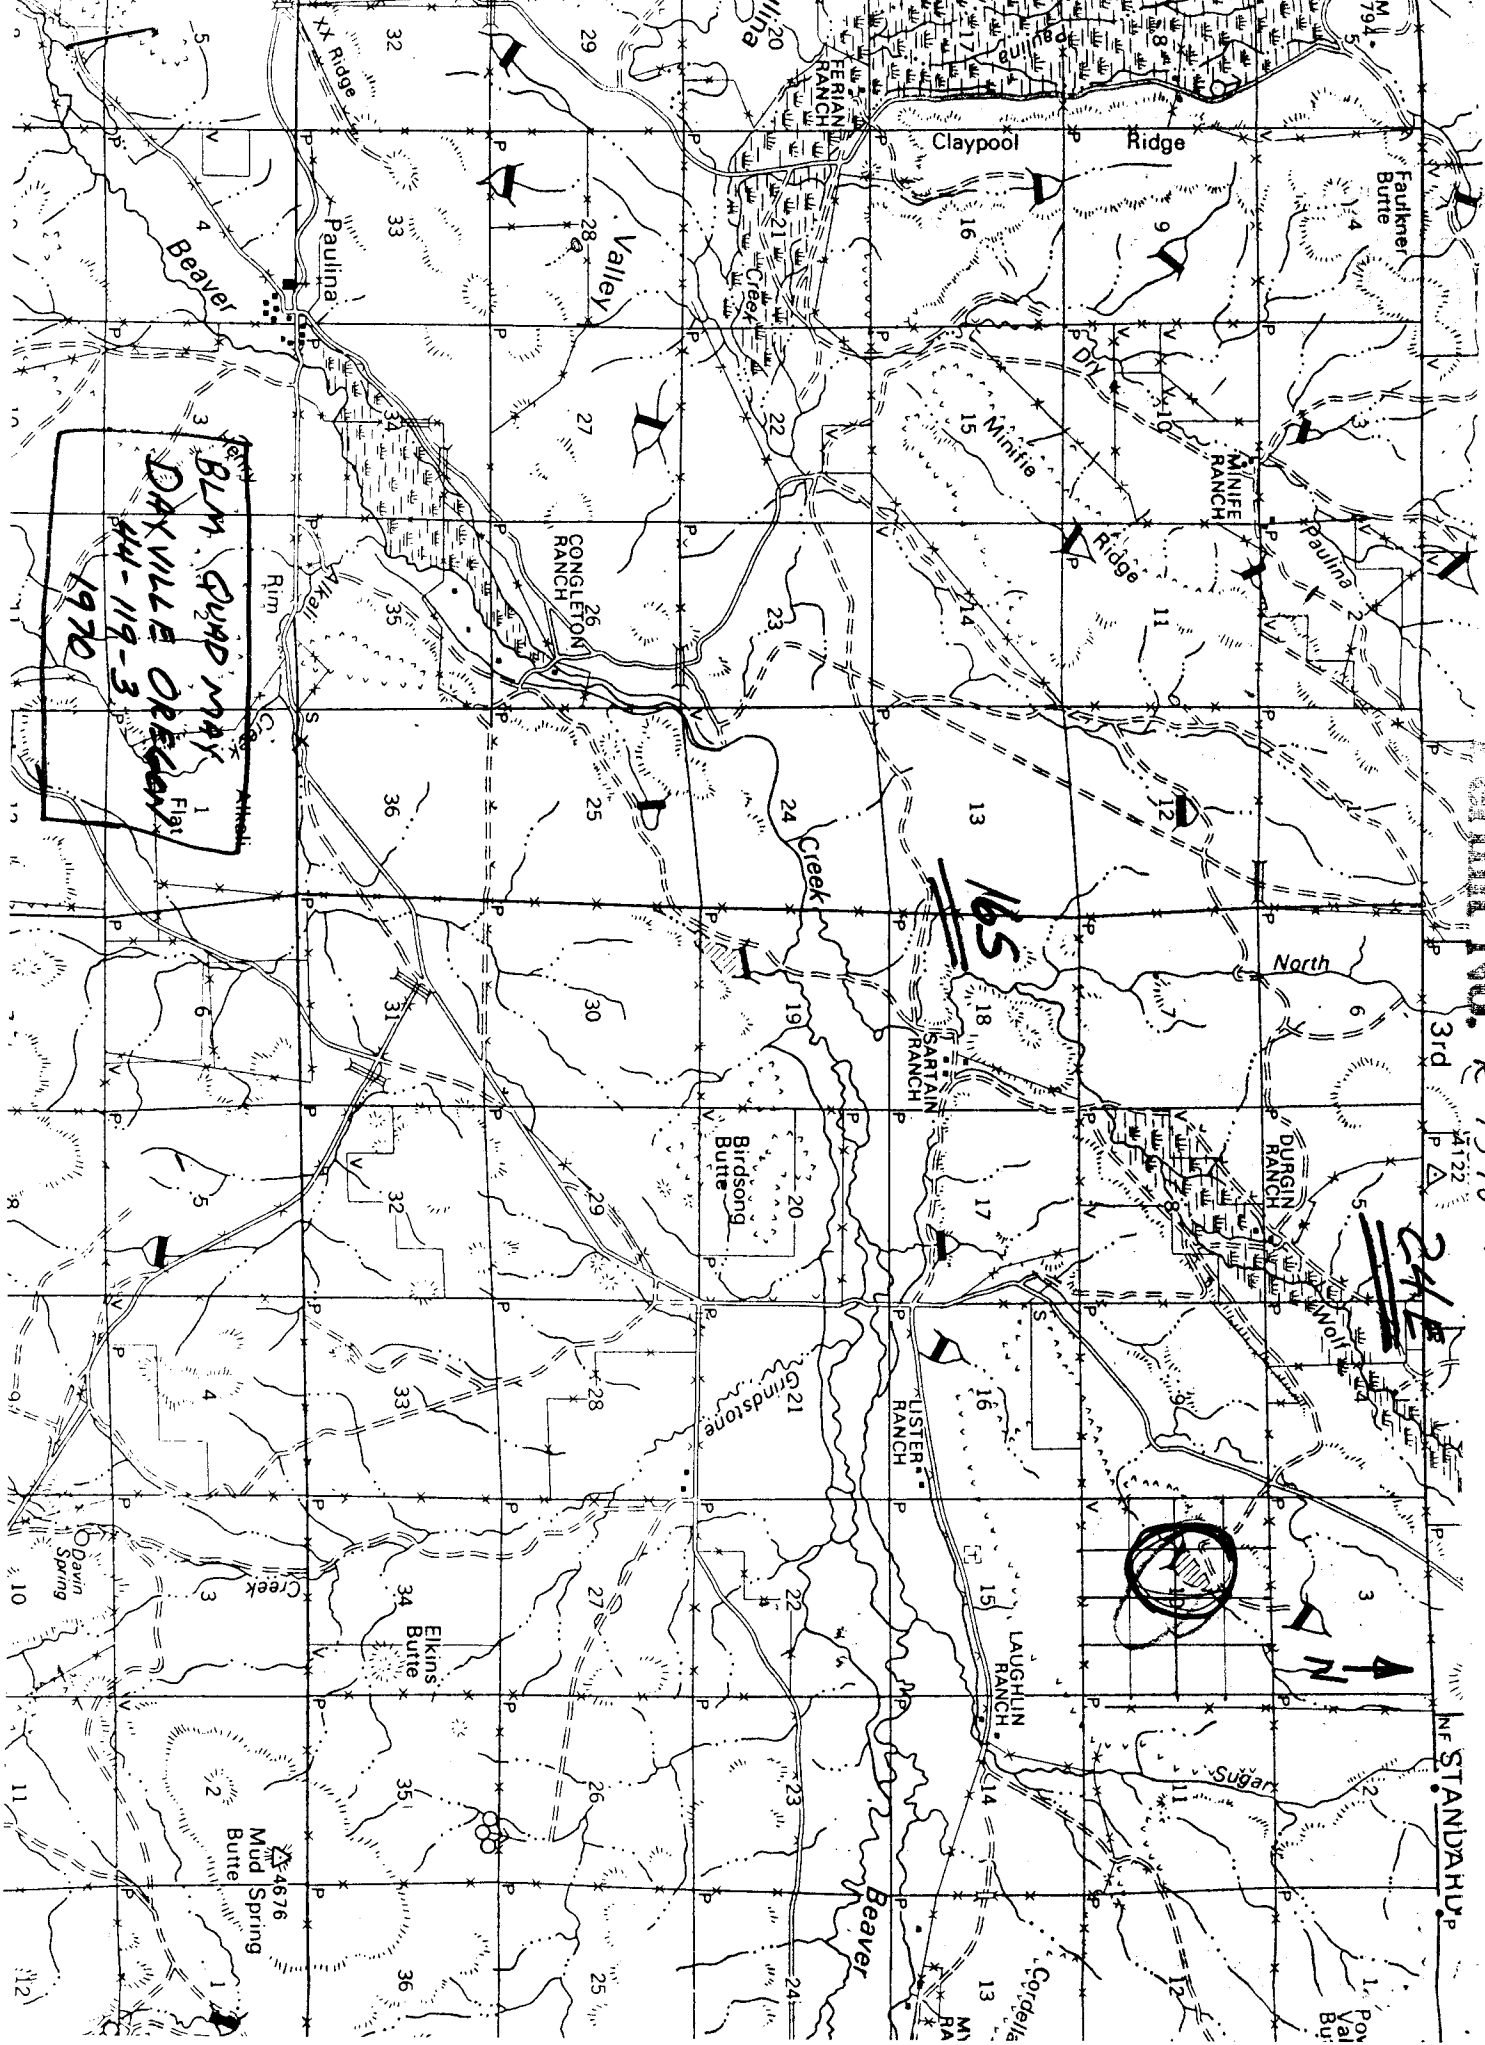

BLM QUAD MAP
DAYVILLE OREGON
44-119-3
1970

165

24E

