


P-5430-2
Nov. 1964

UNITED STATES
DEPARTMENT OF THE INTERIOR
BUREAU OF LAND MANAGEMENT

0606

SECTION DIAGRAM

MAP CONTRACT NO. 14-11-0001()-
T. 22 S. R. 21 E. SEC. 33, Will. MER. Prineville DISTRICT
MAPPER DATE

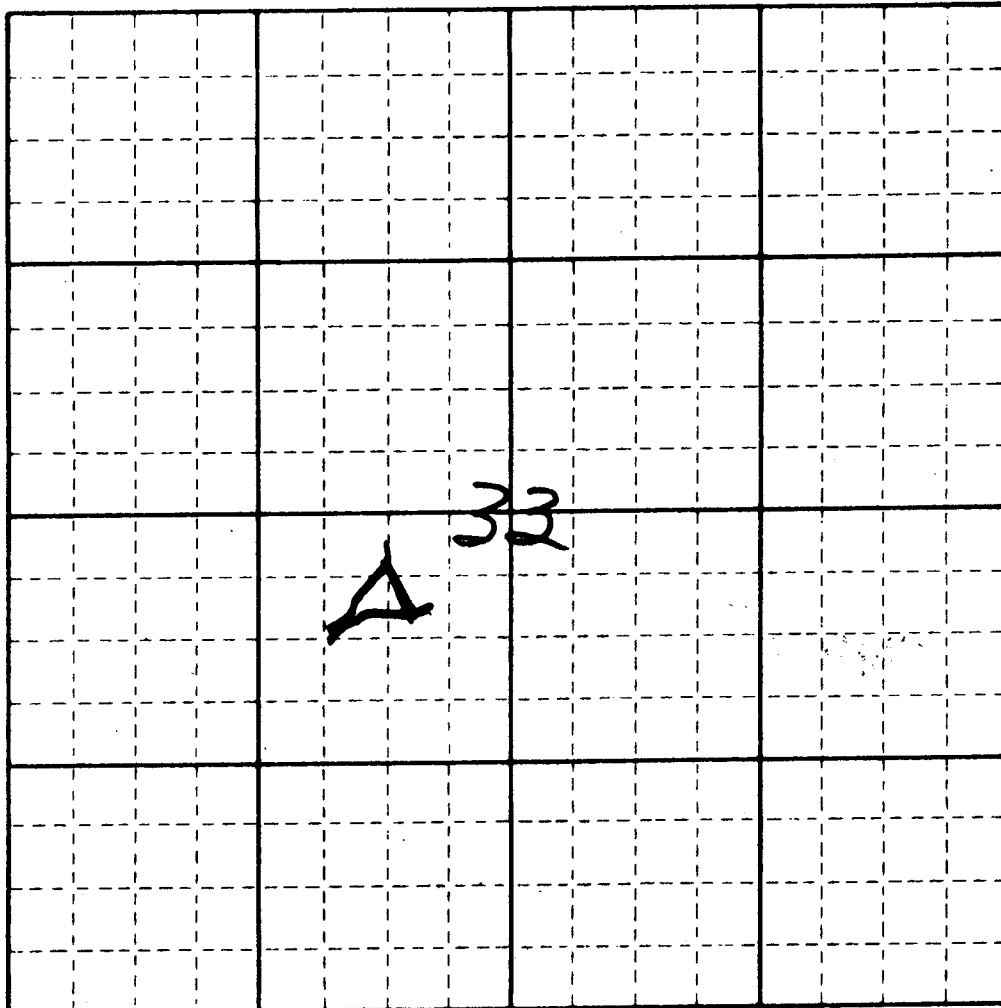

Application No. A-51445
Permit No. R 7731

SCALE: 1" = 1,000 FT.

LEGEND

☐			MAINLINE ROAD
☐			PROPOSED SPUR ROADS
☐			YARDING ROADS (CAT OR HIGH LEAD)
☐			SPAR TREES (YARDING OR LOADING)
☐			CORNERS FOUND
			BOUNDARY - CONTRACT AREA
			BOUNDARY - CUTTING AREA

RECEIVED

NOV 14 1973

STATE ENGINEER
SALEM, OREGON