


RECEIVED
 SEP 6 1978
 WATER RESOURCES DEPT.
 SALEM, OREGON
RECEIVED
 MAY 11 1979
 WATER RESOURCES DEPT.
 SALEM, OREGON

Application No. 58345
 Permit No. 44738

R. 58654
 R 8101

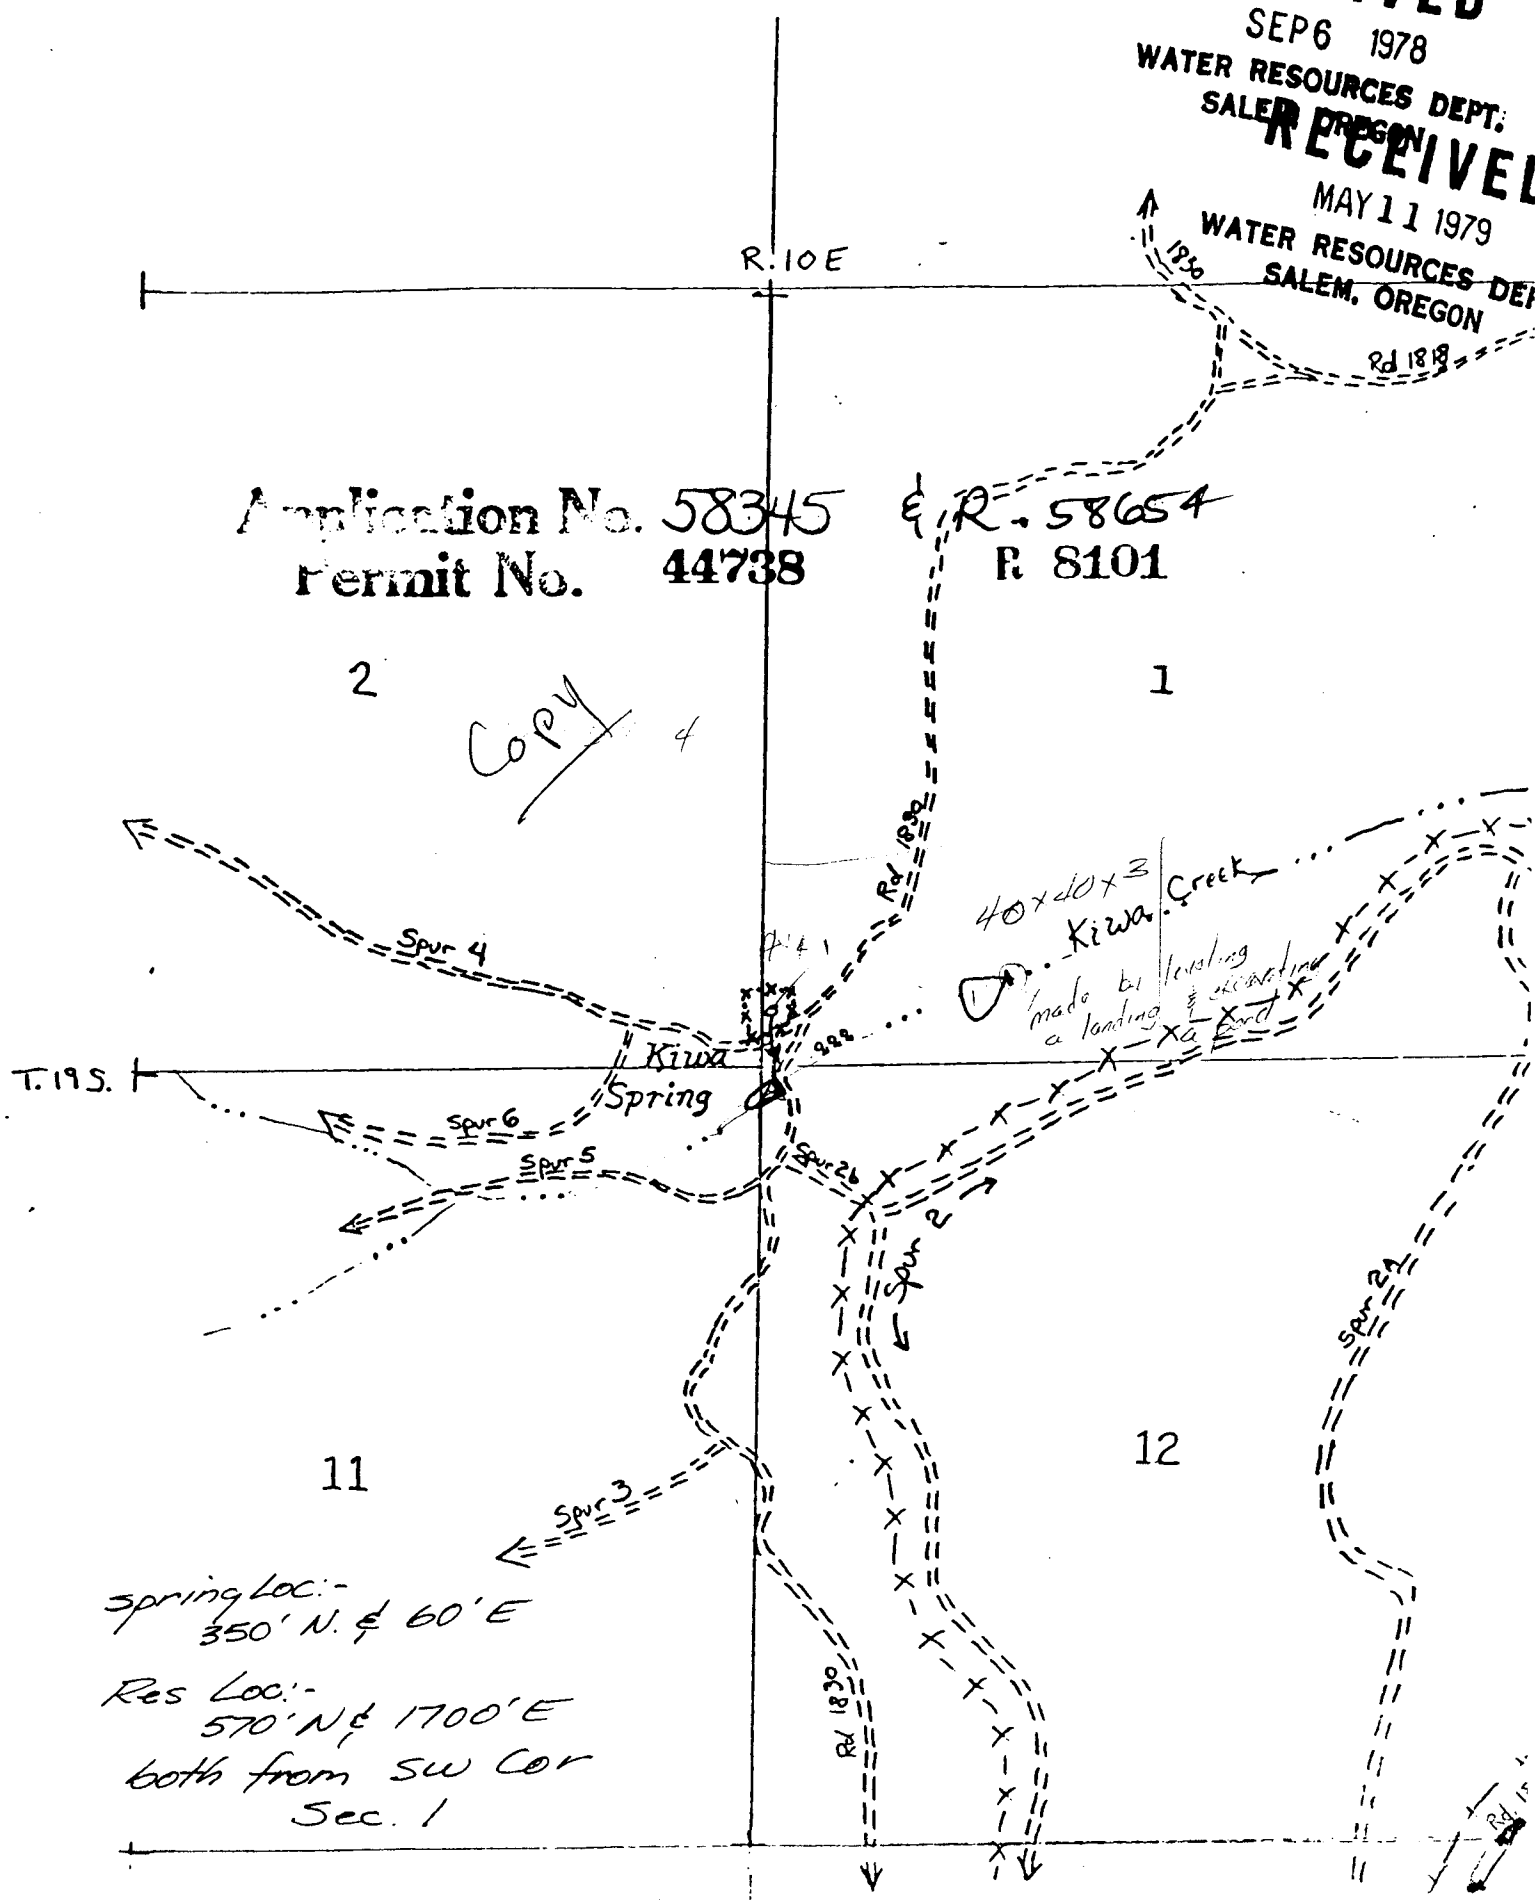

2
 Copy 4

1

11

12

Spring Loc:-
 350' N. & 60' E
 Res Loc:-
 570' N. & 1700' E
 both from SW Cor
 Sec. 1