


Application No. R-63728
Permit No. R 8532

Tyos Raw Sec 11

REG ED
JUL 1 1982
WATER RESOURCES DEPT
SALEM, OREGON

→ Flow of water
= pond
= Roads
Only one Dam in
stream, water runs
around west end
and back into natural
channel.

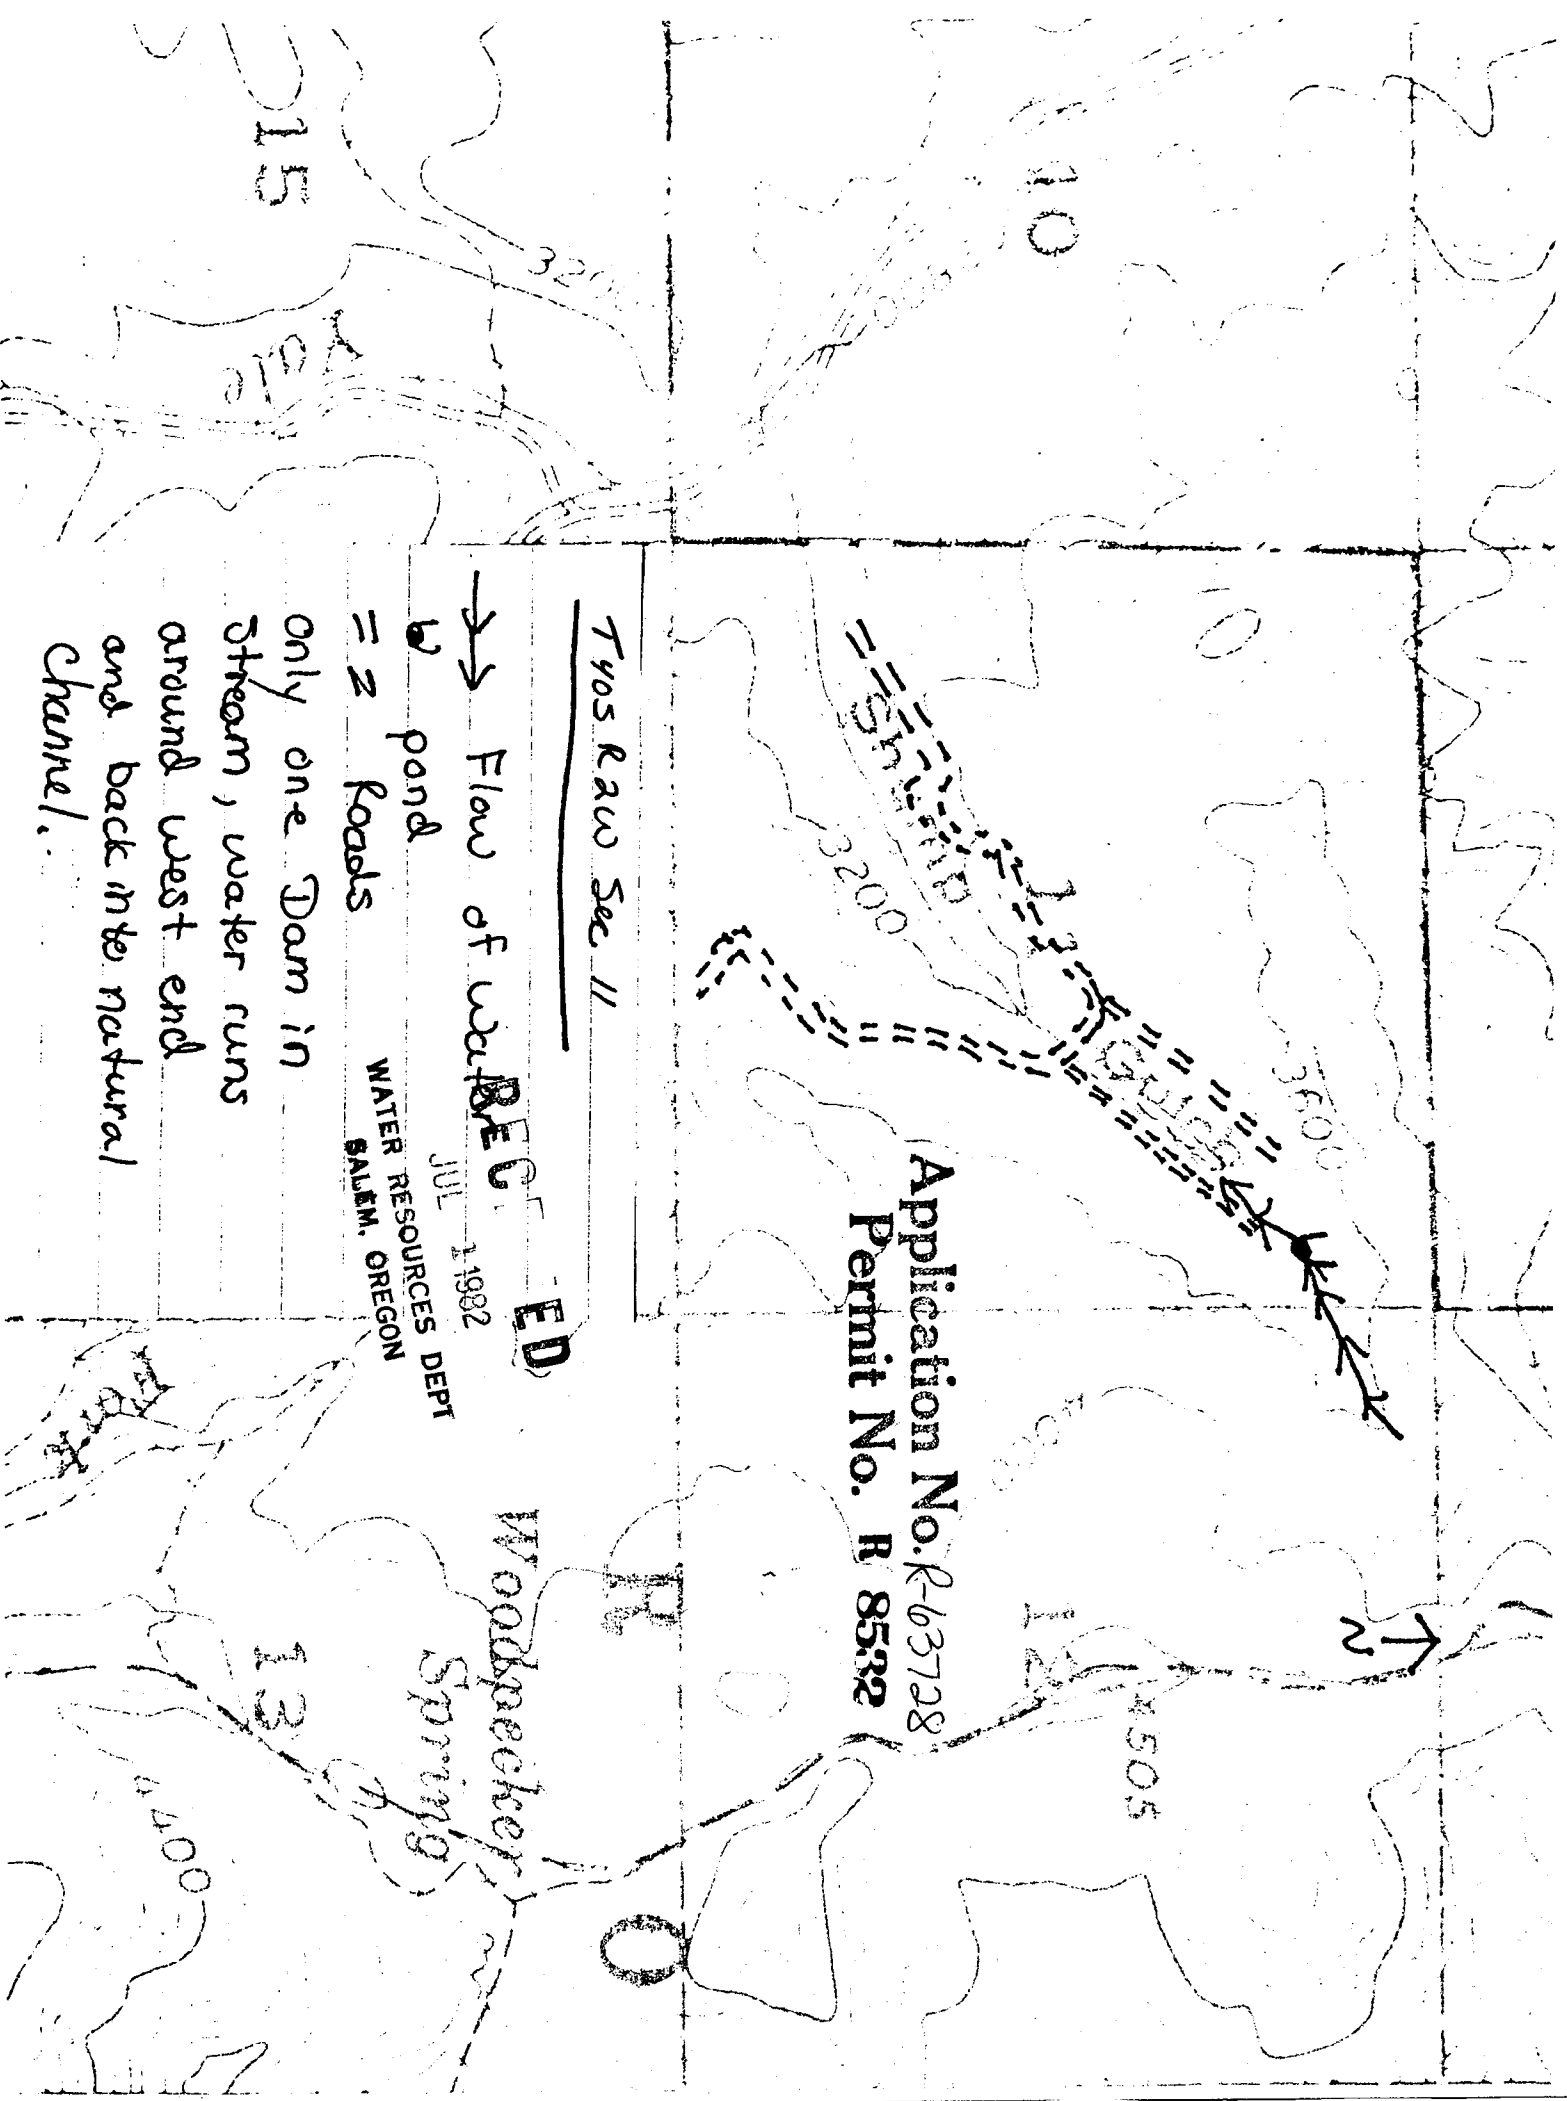

Woodpecker
Spring

13

15

10

4505

3600

3200

4000

14

0