


WATER RIGHTS MAP FOR LOCATION CHANGE

GOV'T. LOT 4 SEC 2 T 23S R 42E W.M.

U.S.G.S. QUAD - HURLEY FLAT, OREG. - 7 1/2'

TIN STOVE
(48-4667)
RESERVOIR

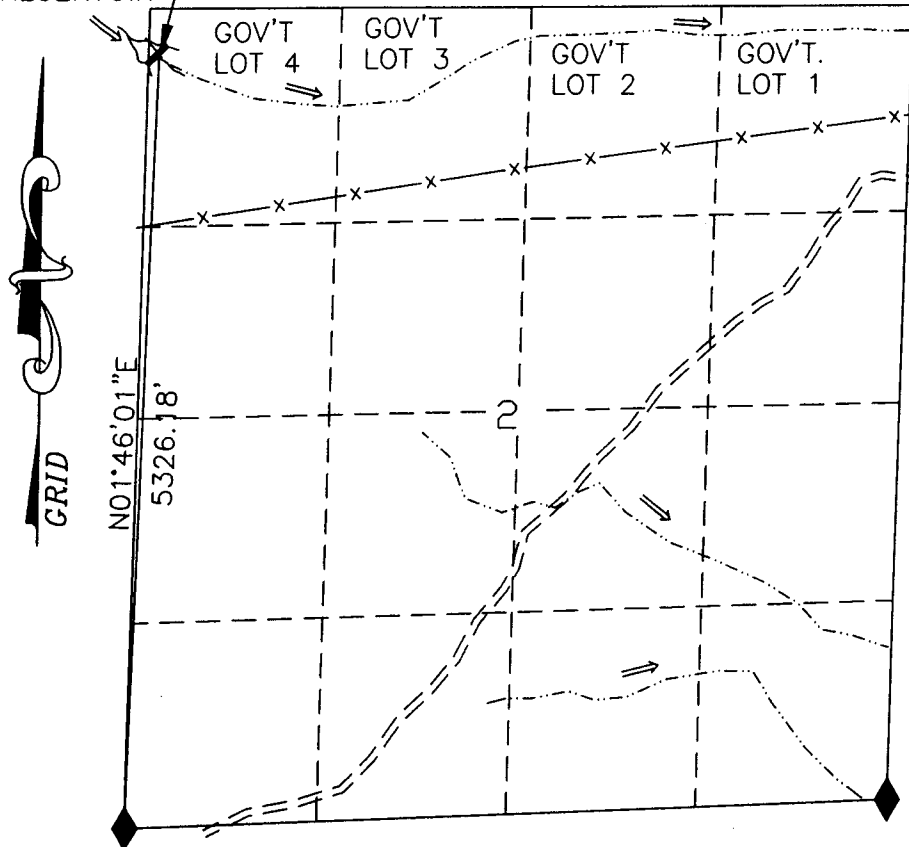

LEGEND

-  RESERVOIR
-  ROAD
-  CHANNEL
-  FD SEC COR
-  FENCE

RECEIVED

APR 14 2003

TIN STOVE (48-4667) RESERVOIR

WATER RESOURCES DEPT.
SALEM, OREGON

LOCATIONS OF THE RESERVOIR AND
SECTION CORNER ARE FROM GPS POSITIONS
AND THE BEARING IS IN OREGON SOUTH
STATE PLANE COORDINATES.



SCALE 1"=1320'

THIS MAP IS FOR THE PURPOSE OF LOCATING
A WATER RIGHT AND IS NOT INTENDED TO
PROVIDE LEGAL DIMENSIONS FOR LOCATION
OF PROPERTY BOUNDARIES.



ACAD 2000i
DWG FILE: TINSTOVE

UNITED STATES DEPARTMENT OF THE INTERIOR BUREAU OF LAND MANAGEMENT DIVISION OF OPERATIONS VALE DISTRICT	
TIN STOVE (48-4667) RESERVOIR	
DESIGNED	
REVIEWED	<i>[Signature]</i>
APPROVED	<i>[Signature]</i> CHIEF, BRANCH OF ENGINEERING
DRAWN: CG	SCALE: 1"=1320'
DATE: 2/21/02	SHEET 1 OF 1
DRAWING NO. OR-03-9172.45-1120	