


Form A1-187
March 1961

UNITED STATES
DEPARTMENT OF THE INTERIOR
BUREAU OF LAND MANAGEMENT

SECTION: 15
SW 1/4 NE 1/4

Oregon State Water Filings

TOWNSHIP 18 S, RANGE 22 E, W. M.

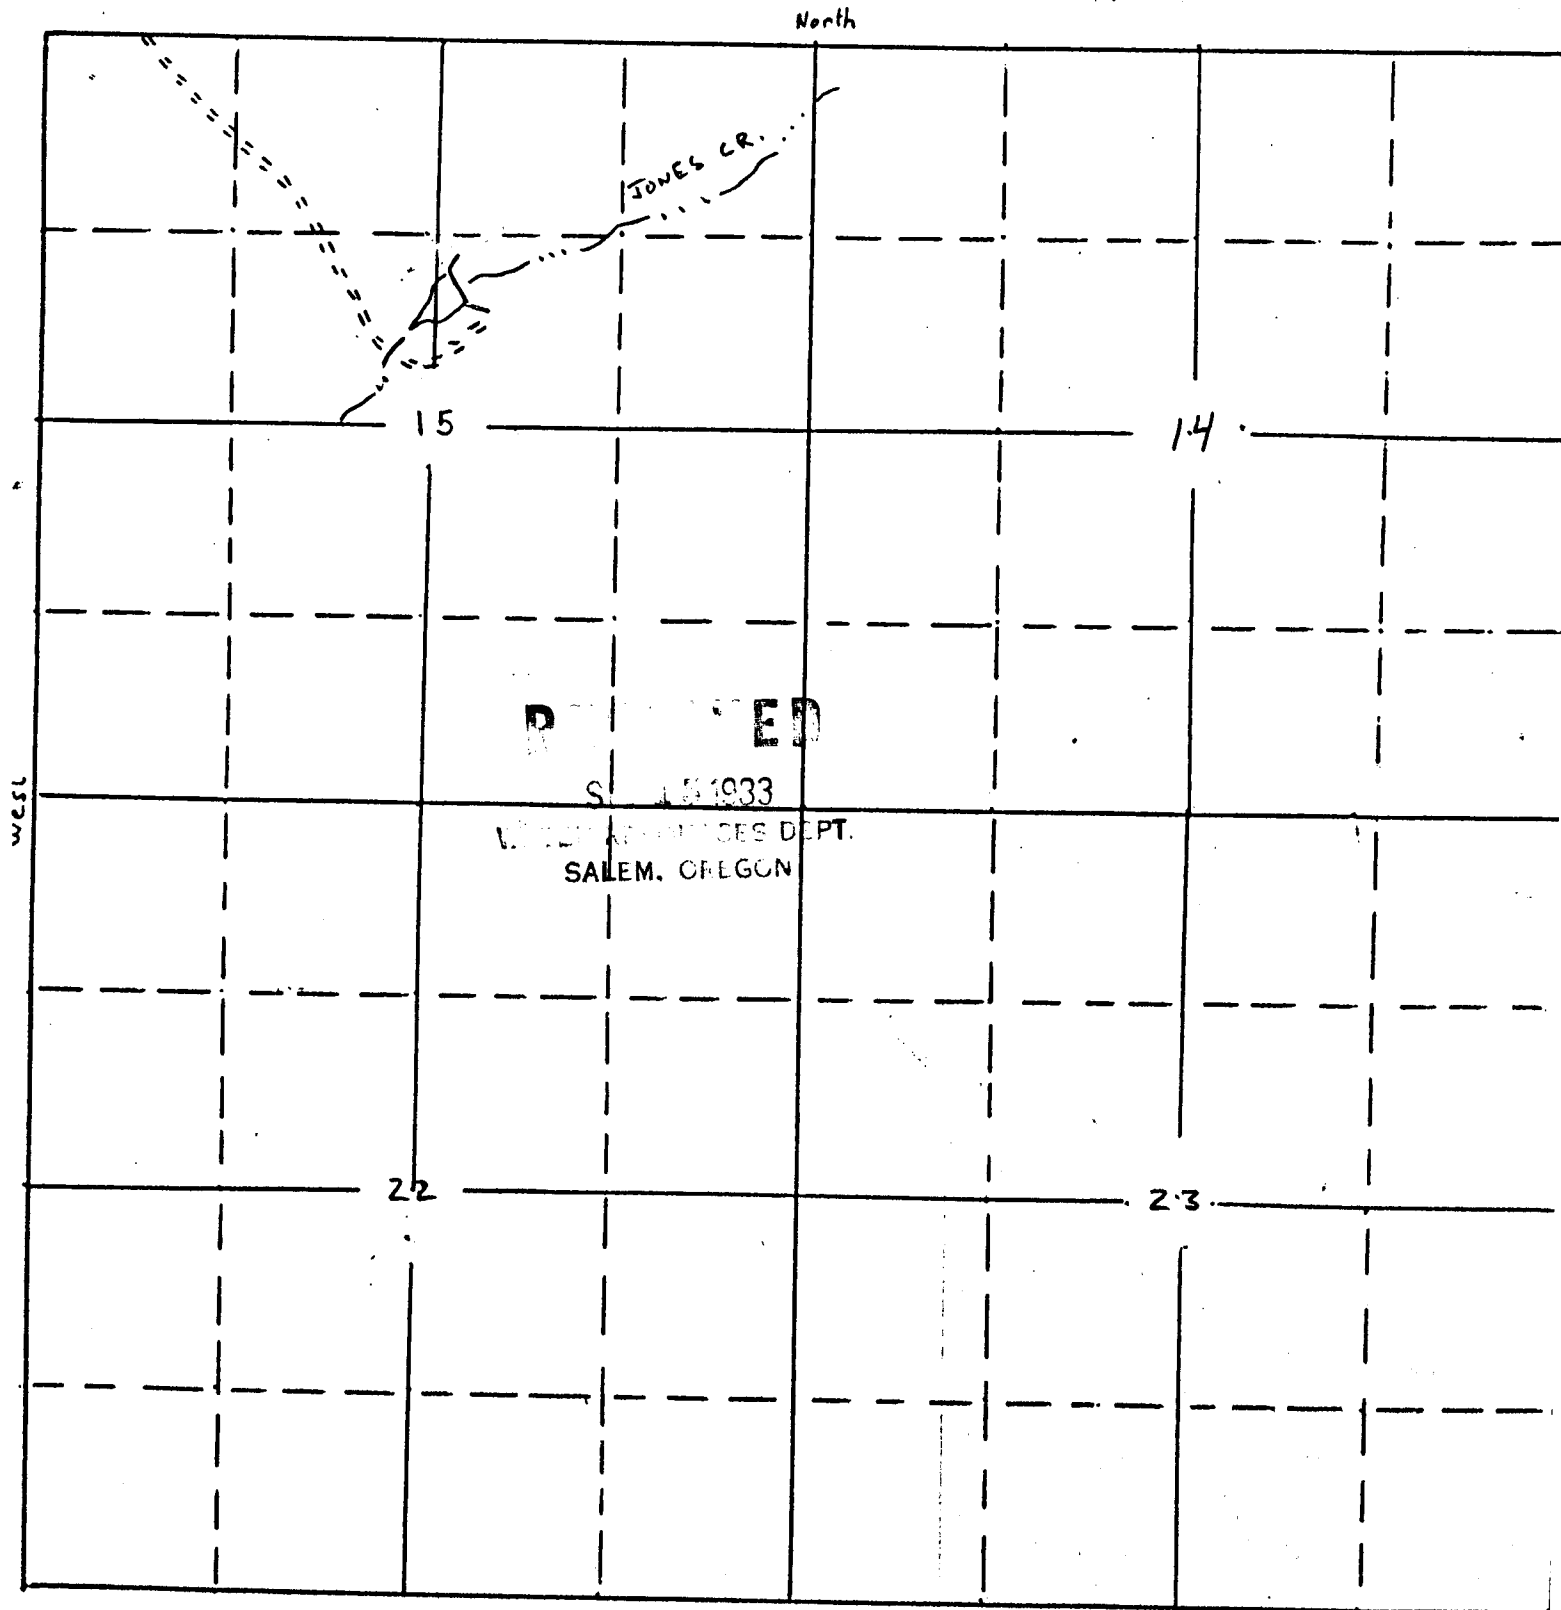

South

APPLICATION No.
PERMIT No.

R-66061
R10062