


1-187
1961


SECTION: 36
NW 1/4 SE 1/4

Oregon State Water Filings

TOWNSHIP 19 S, RANGE 21 E, W. M.

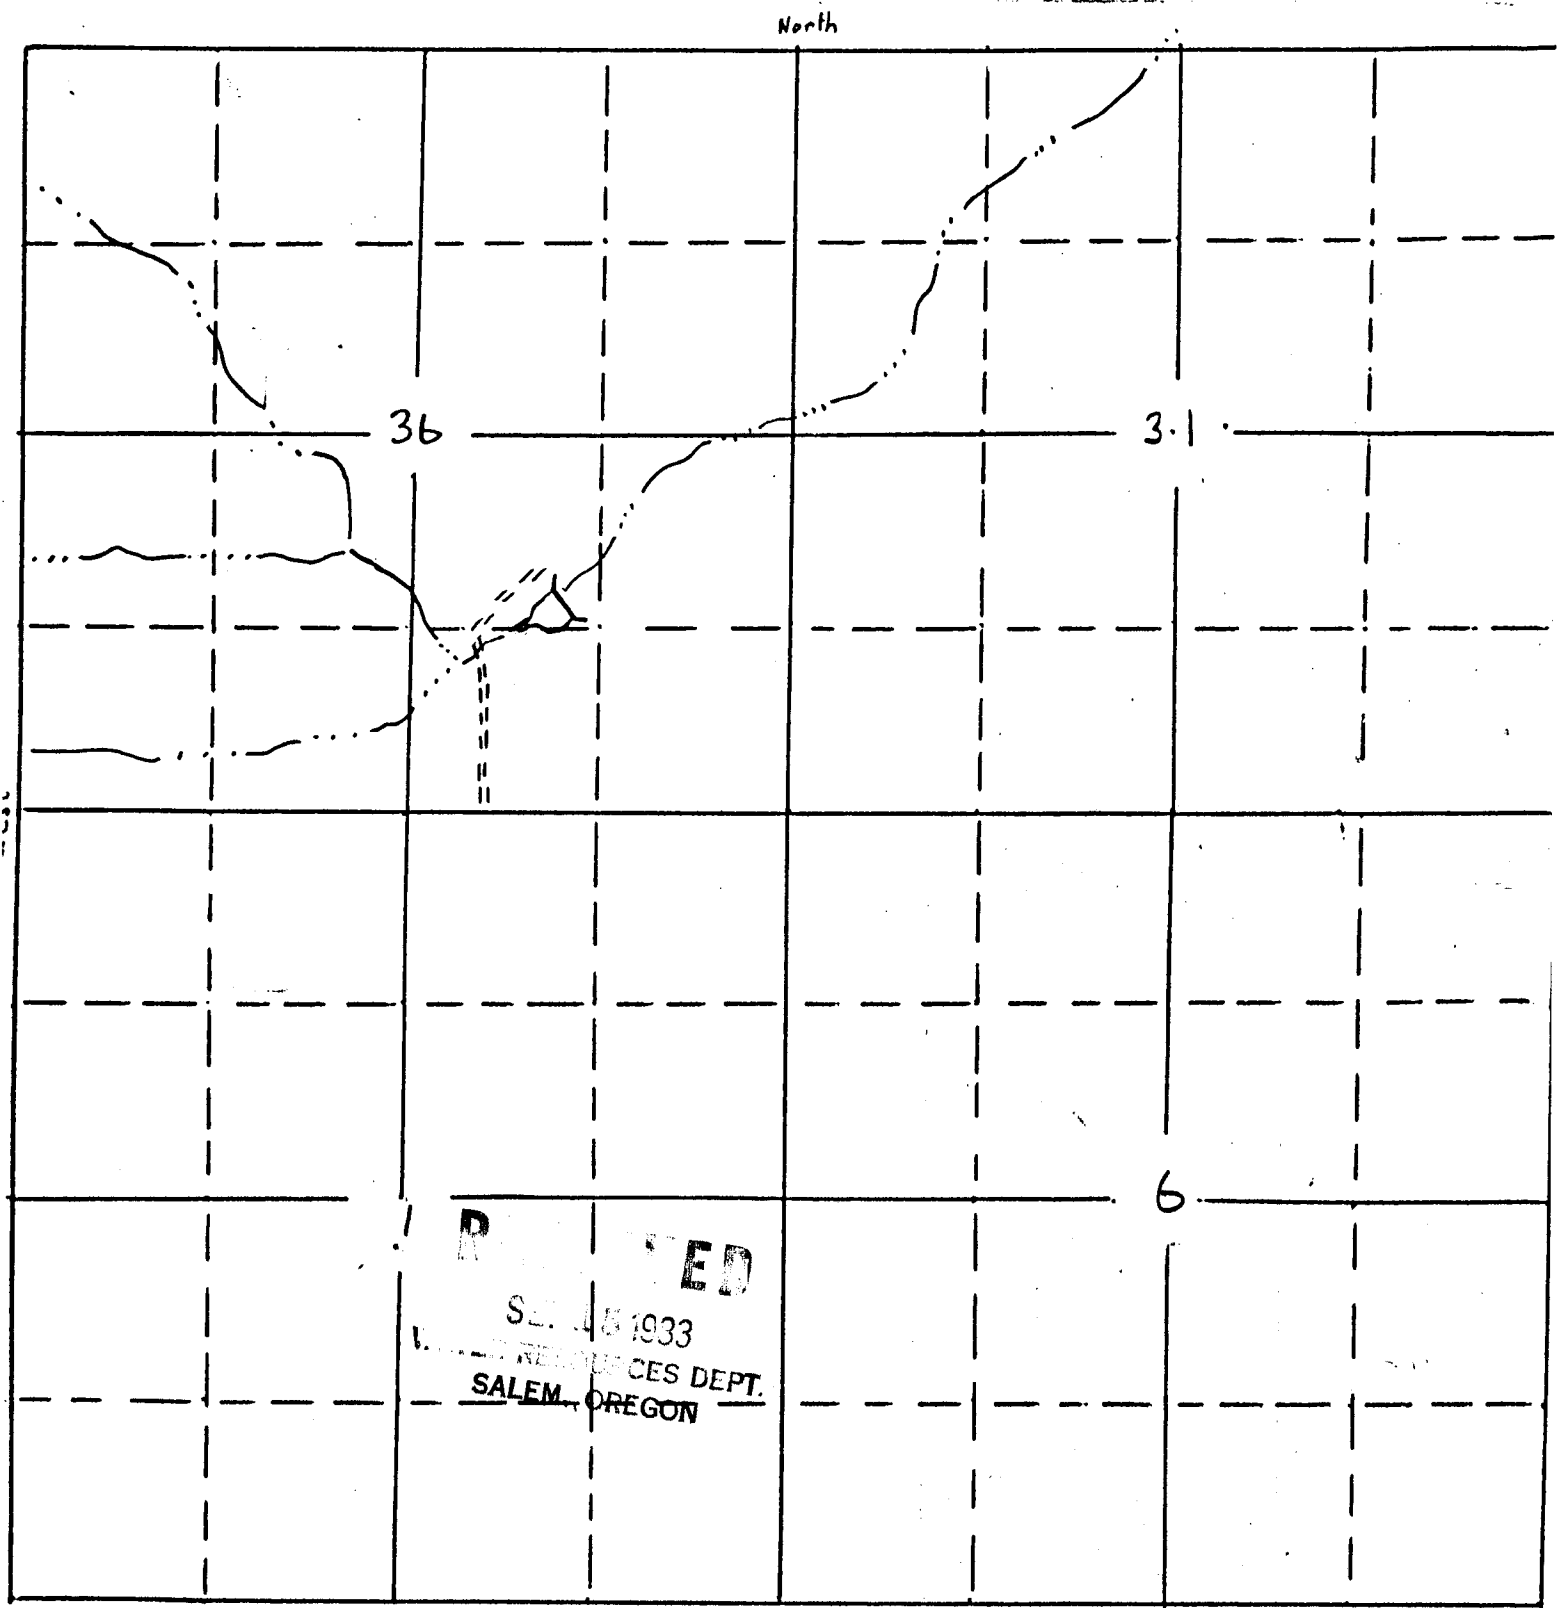

APPLICATION No. R-66064
PERMIT No. R10065