

March 1961

DEPARTMENT OF THE INTERIOR
BUREAU OF LAND MANAGEMENT

SECTION: 35


Oregon State Water Filings

SE 1/4 NW 1/4

TOWNSHIP 19S, RANGE 21E, W. M.

North

West

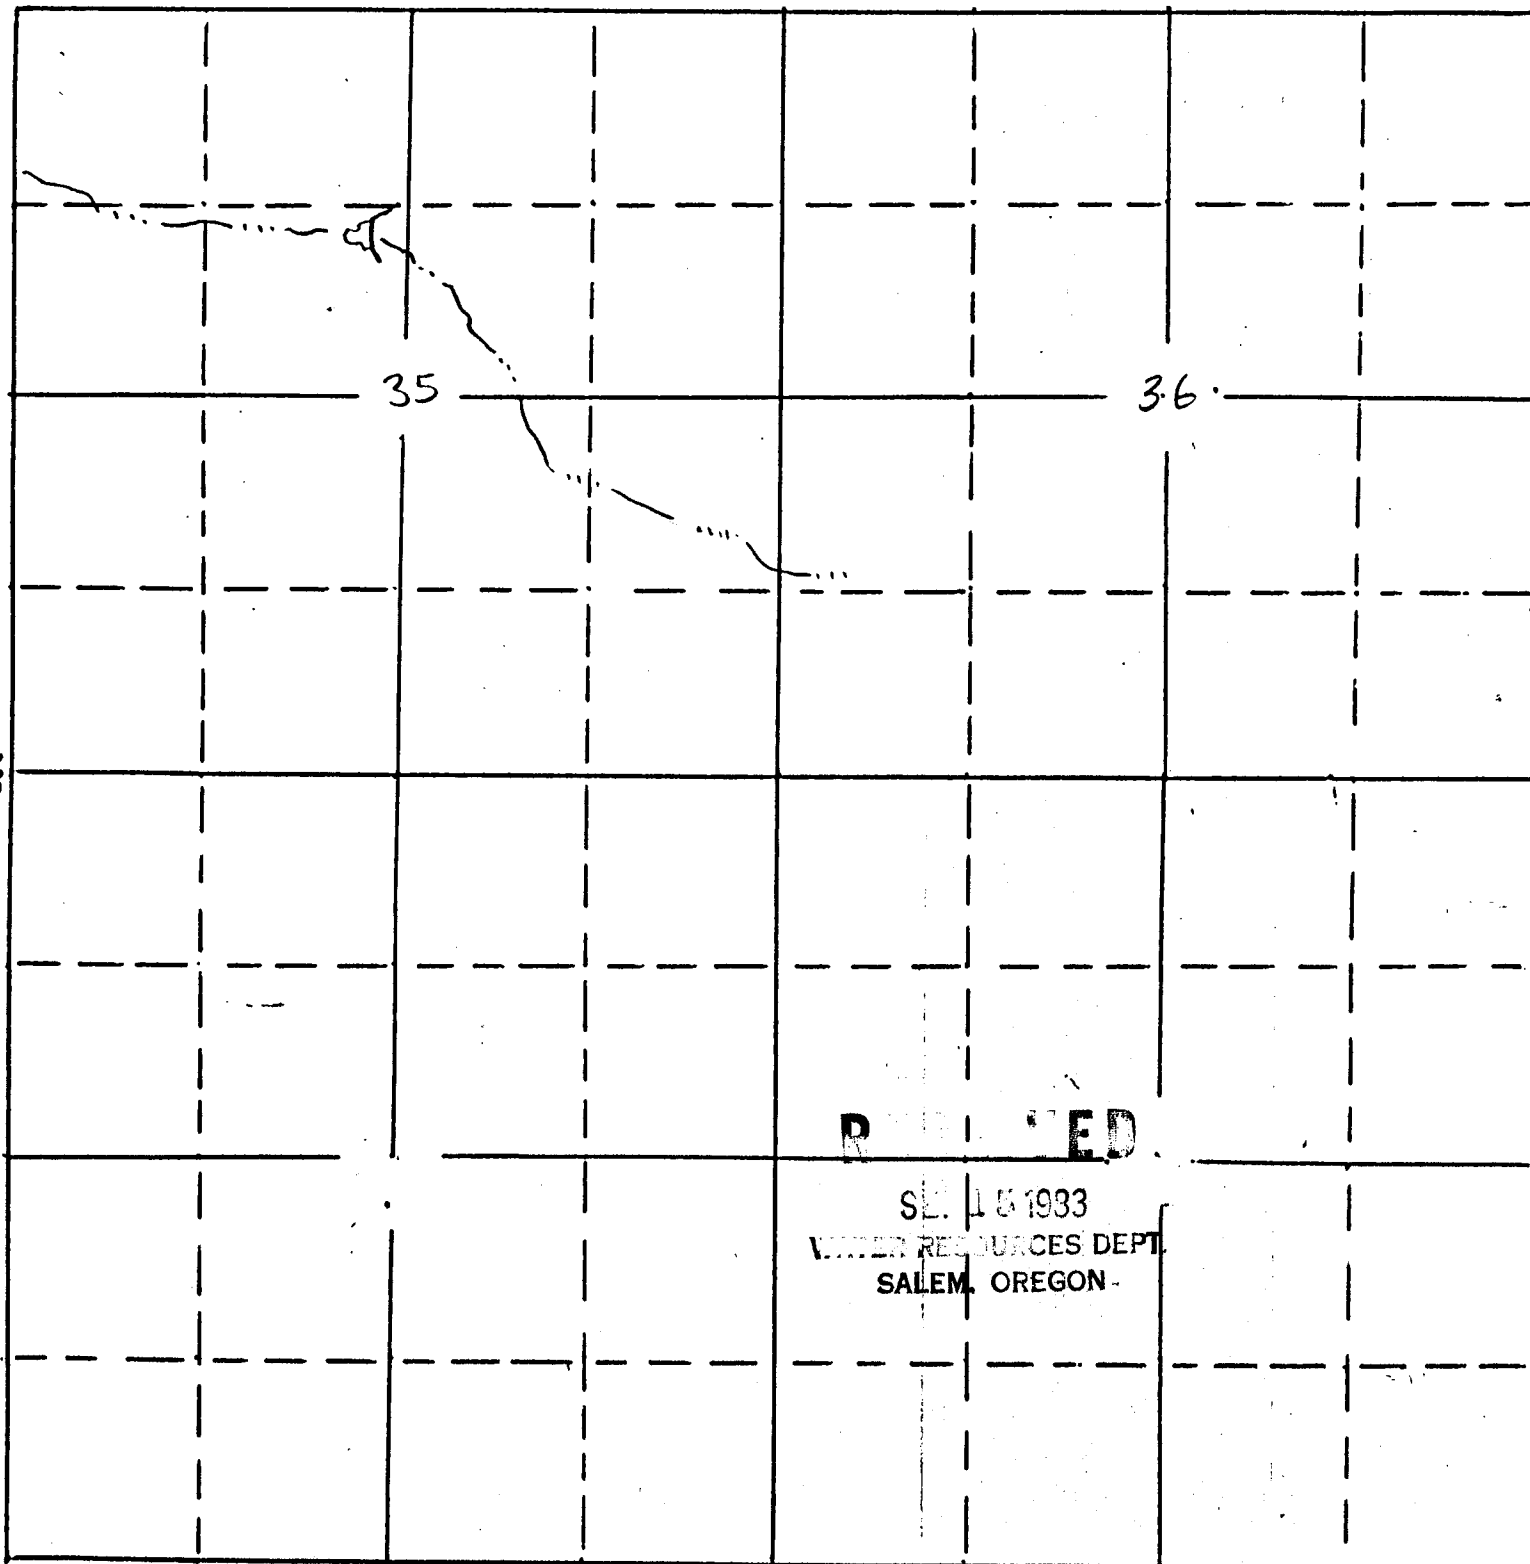

RECEIVED

WATER RESOURCES DEPT.
SALEM, OREGON

South

APPLICATION No.
PERMIT No.

R-66065
R10066