

A1-187

h 1961

UNITED STATES
DEPARTMENT OF THE INTERIOR
BUREAU OF LAND MANAGEMENT

SECTION: 25


NW 1/4 SW 1/4

Oregon State Water Filings

TOWNSHIP 17 S, RANGE 21 E, W. M.

North

West

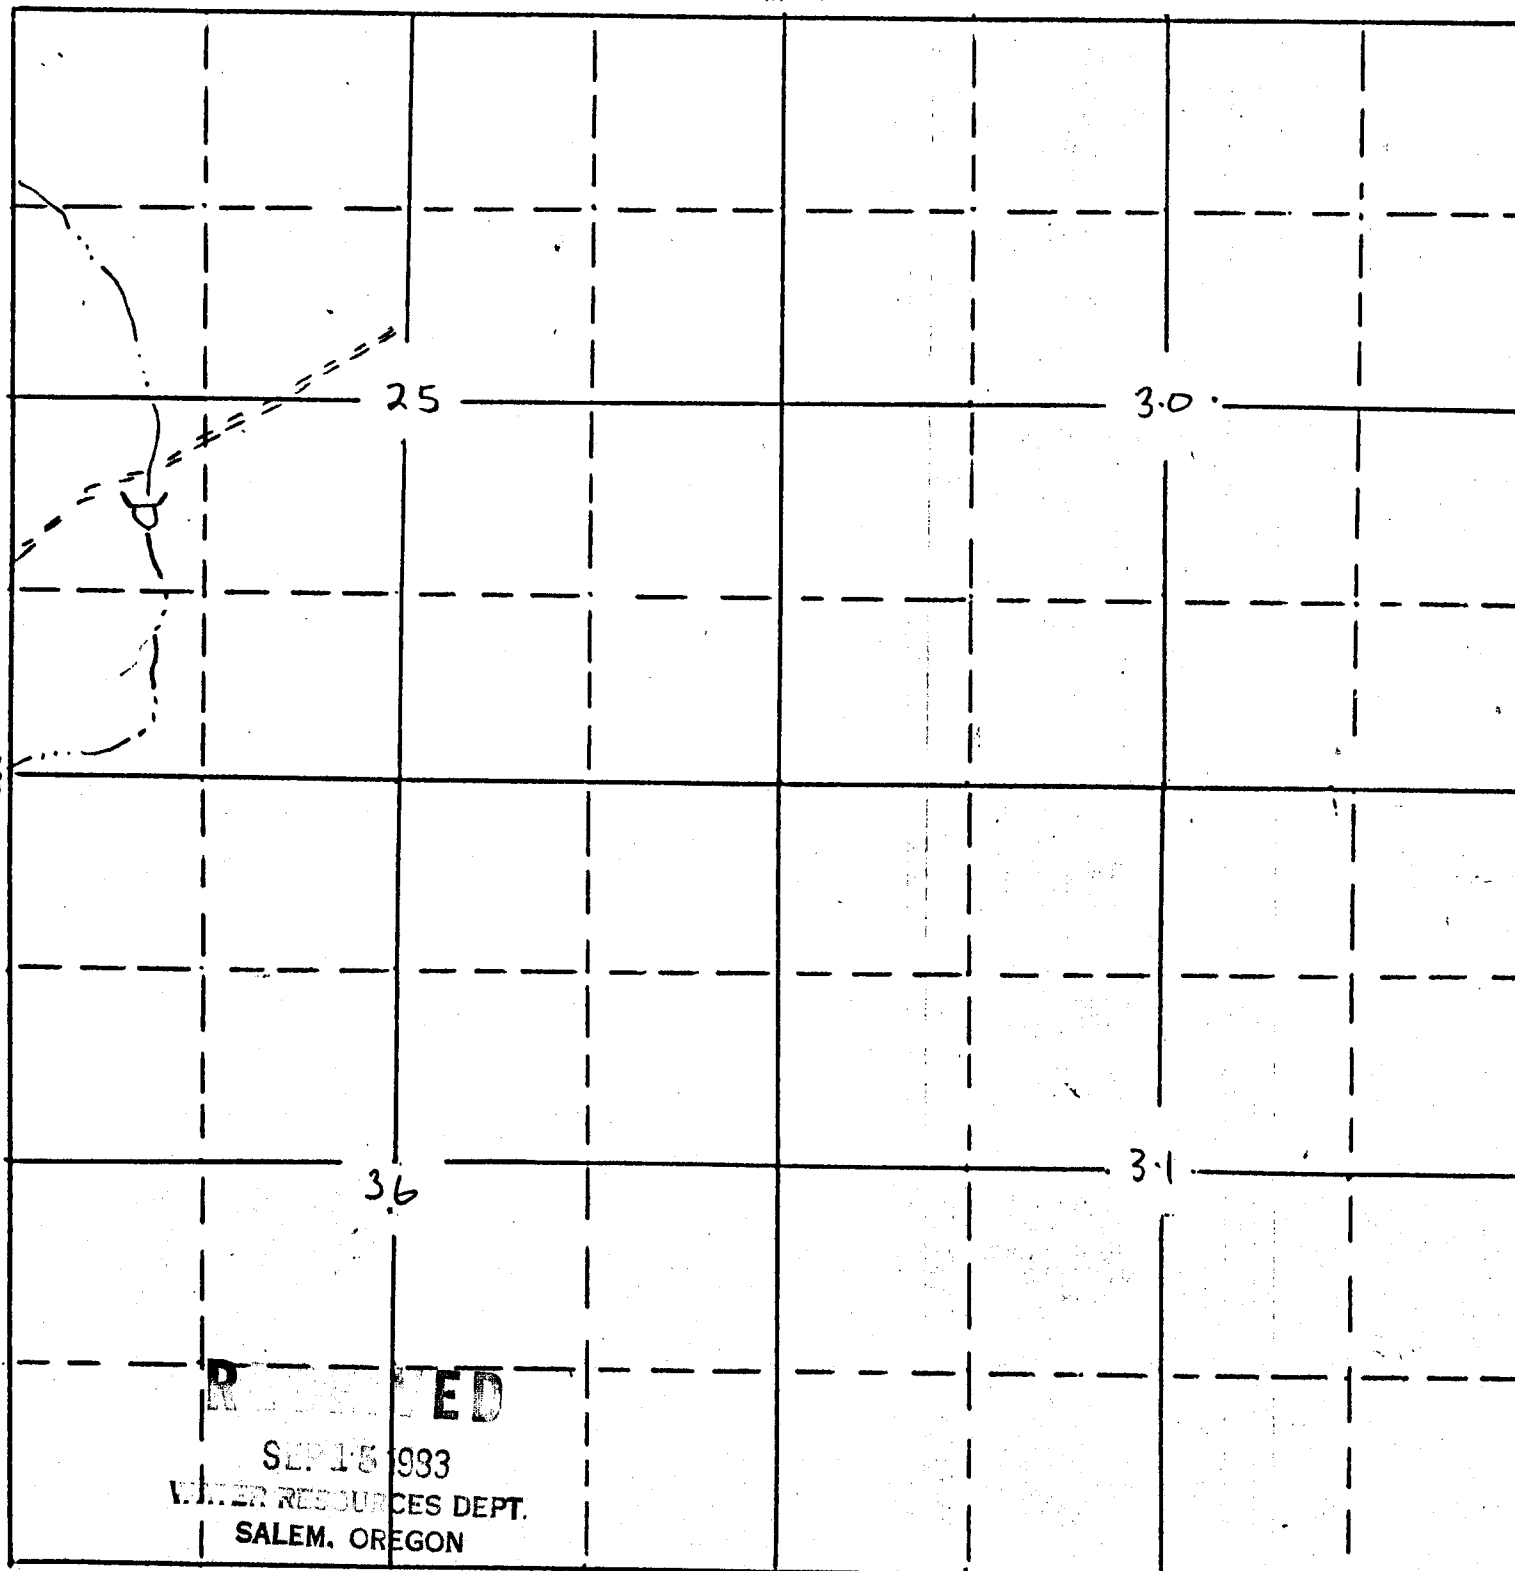

RECEIVED
SEP 15 1983
WATER RESOURCES DEPT.
SALEM, OREGON

South

APPLICATION No.
PERMIT No.

R-66073
R10073