

1-187
1961


UNITED STATES
DEPARTMENT OF THE INTERIOR
BUREAU OF LAND MANAGEMENT

SECTION: 25

NE 1/4 NE 1/4

Oregon State Water Filings

TOWNSHIP 17S, RANGE 21E, W. M.

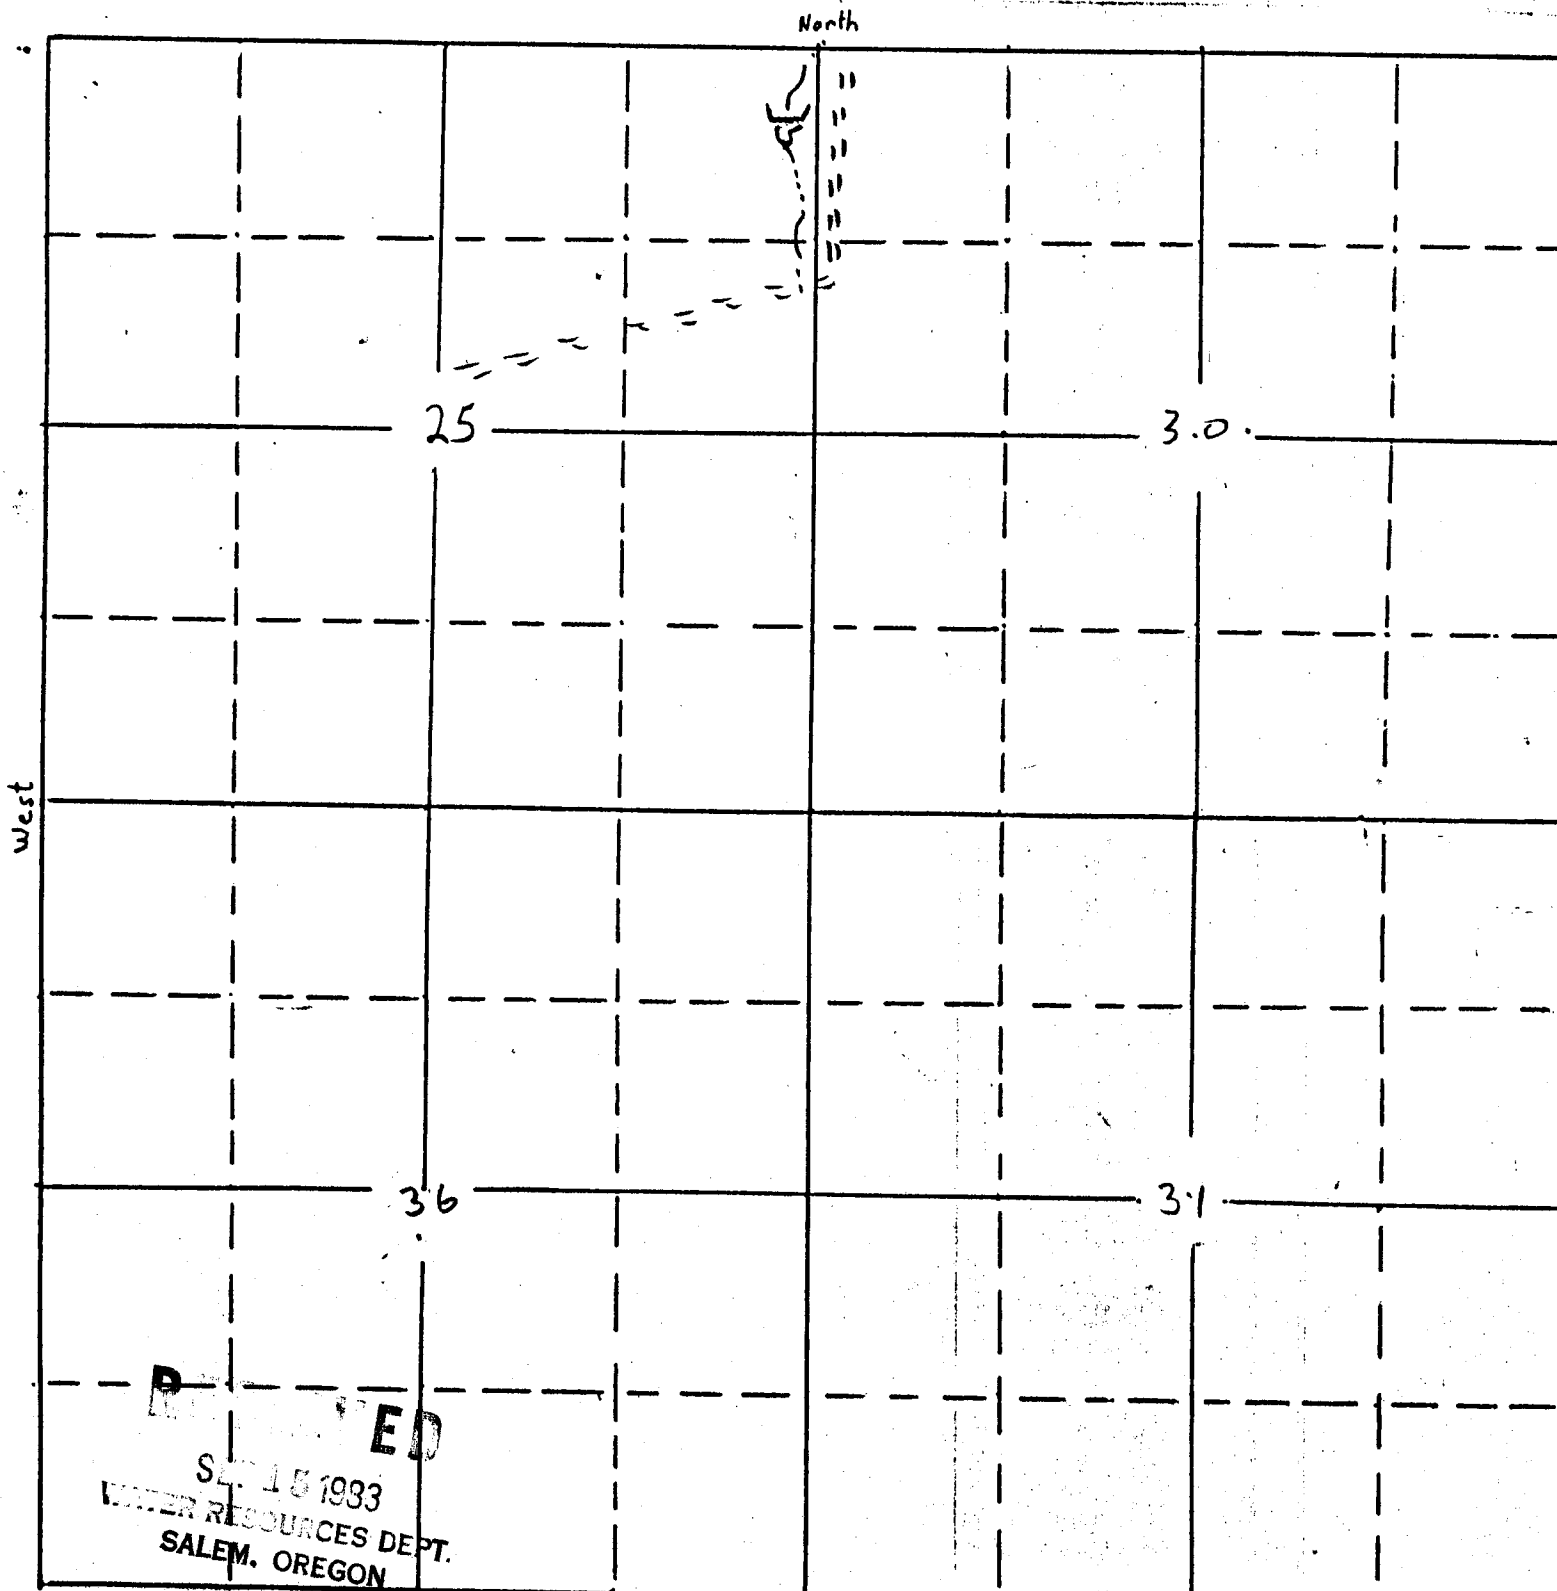

South

APPLICATION No.

PERMIT No.

R-66075

R10075