
CATHCART WATER WORKS

T. 14 S. R. 8 W. W.M.

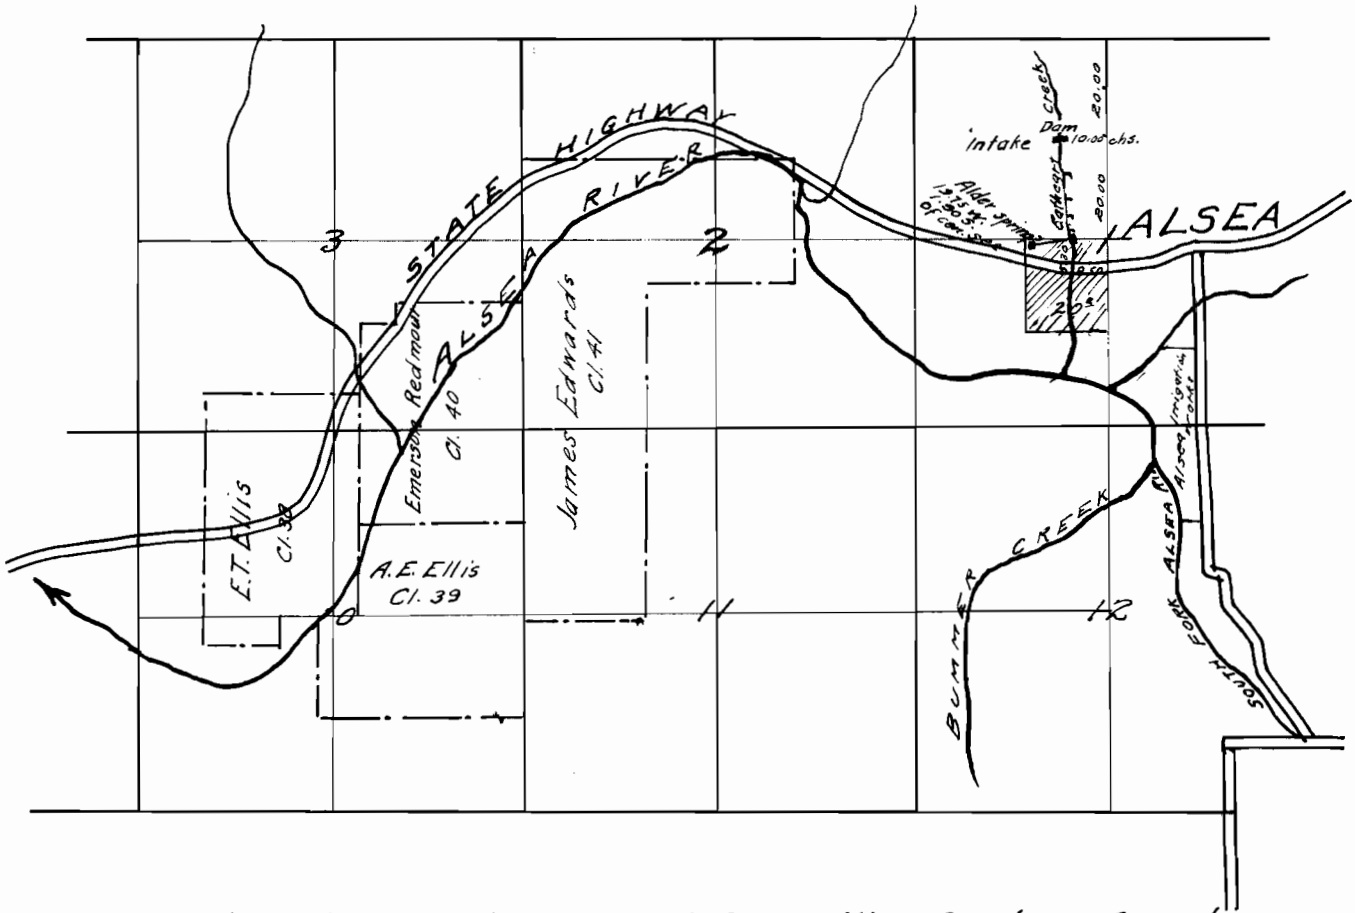

I, W. C. Galloway, of Corvallis, Benton County, Oregon, do hereby certify that this map was made from notes taken during actual surveys made under my direction on November 15, 1926, and that it correctly represents the works described in the accompanying application, together with the location of streams and other ditches in the immediate vicinity.

W. C. Galloway
COUNTY ENGINEER
ORE. REG. No. 44

Scale:- 1 in = 40 chs.

Application No. 1179
Permit No. 7679