


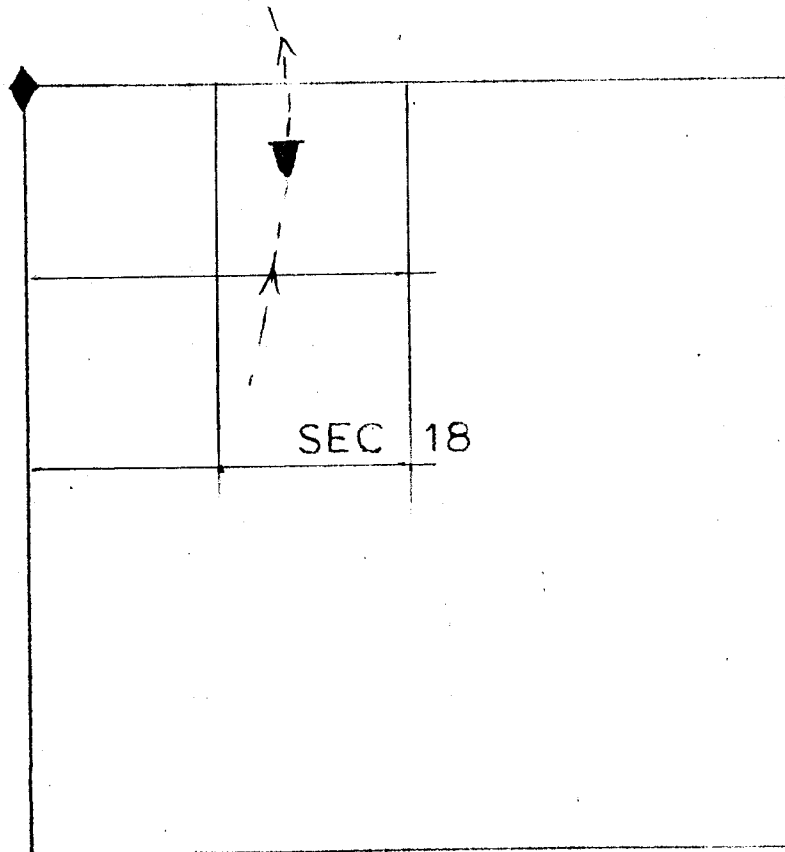

**RECEIVED**

JAN 28 1986

WATER RESOURCES DEPT  
SALEM, OREGON

**RECEIVED**

NOV 13 1986

WATER RESOURCES DEPT  
SALEM, OREGON

RESERVOIR IS 1900' EAST AND 420' SOUTH  
OF THE NORTHWEST COR. OF SEC. 18 T. 17 S.  
R. 25 E.

Application No. **R-68531**  
Permit No. **R10608**

|                                                               |                                      |
|---------------------------------------------------------------|--------------------------------------|
| U. S. DEPARTMENT OF THE INTERIOR<br>BUREAU OF LAND MANAGEMENT |                                      |
| BAGLEY # 2 RESERVOIR                                          |                                      |
| DESIGNED _____                                                | RECOMM. _____                        |
| DRAWN <u>LJ</u>                                               | RECOMM. _____<br>CHIEF, DIV. OF ENG. |
| CHECKED _____                                                 | APPROVED _____                       |
| SCALE 4" = 1 MILE                                             |                                      |
| DATE _____                                                    | SHEET _____ OF _____                 |
| DRAWING NO. _____                                             |                                      |