


RECEIVED

NOV 13 1986

WATER RESOURCES DEPT.
SALEM, OREGON

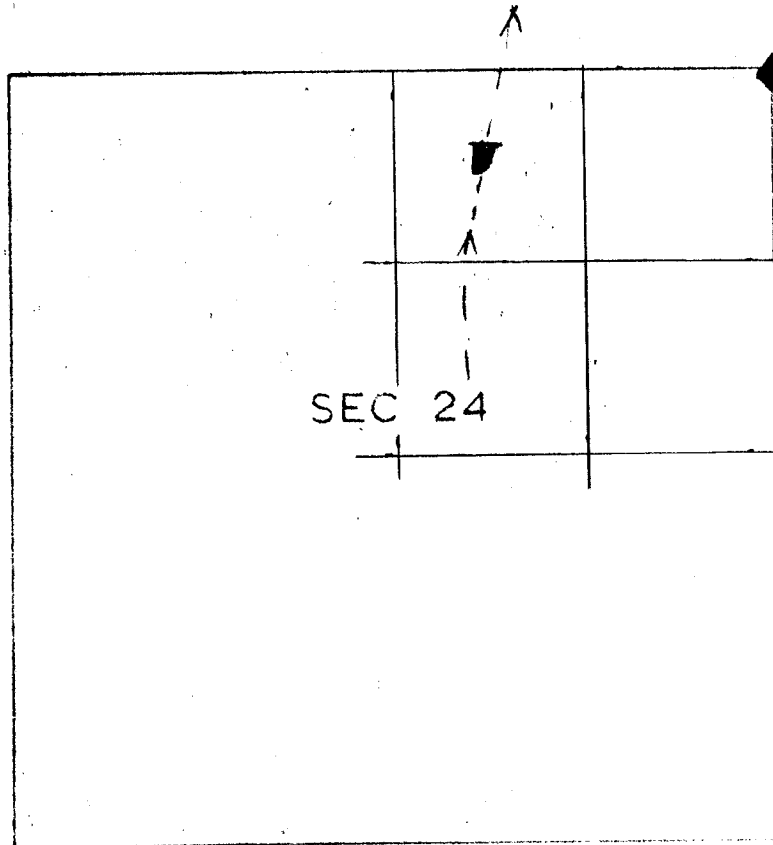

RESERVOIR IS 1975' WEST AND 490' SOUTH
OF THE NORTHEAST COR OF SEC. 24 T.17 S.
R.24 E.

RECEIVED

JAN 28 1986

WATER RESOURCES DEPT.
SALEM, OREGON

Application No. R-68532

Permit No. R10609

U. S. DEPARTMENT OF THE INTERIOR
BUREAU OF LAND MANAGEMENT

BAGLEY #1 RESERVOIR

DESIGNED _____

DRAWN LJ

CHECKED _____

RECOMM. _____

RECOMM. _____

APPROVED _____

CHIEF, DIV. OF ENG.

SCALE 4" = 1 MILE

DATE _____

SHEET _____ OF _____

DRAWING NO. _____