


T.24S., R.18E., W.M.

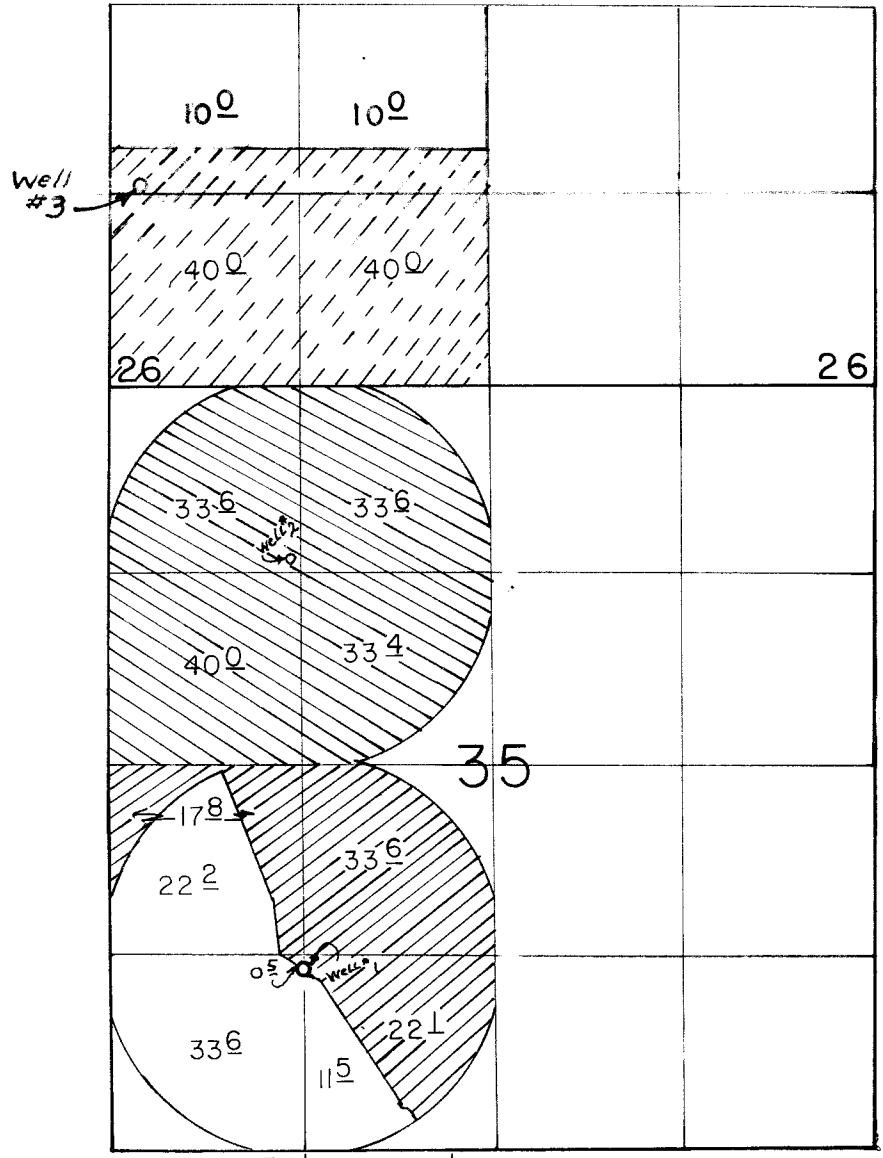

WELL 1, 1250' N & 1320' E FROM SW COR. OF SEC 35.  
 WELL 2, 1200' S & 1250' E FROM NW COR. OF SEC 35.  
 WELL 3, 1360' N & 200' E FROM SW COR. OF SEC 26.

SCALE: 1" = 1320'

### FINAL PROOF SURVEY UNDER

RECORDED  
 10/1/97  
 WATER RESOURCES DIVISION  
 SALT SPRINGS

CERT. NO. 53148  
 Application No. G-11234 Permit No. G-9974  
 Application No. G-10366 Permit No. G-10326  
 IN NAME OF

HAROLD A. BROWN

Surveyed MAY 8 19 97, by R.M. SUTTERFIELD

Revised 5/13/03 DC  
 Revised 7/23/02  
 P.T.S. 11-7-97 R.M.S.