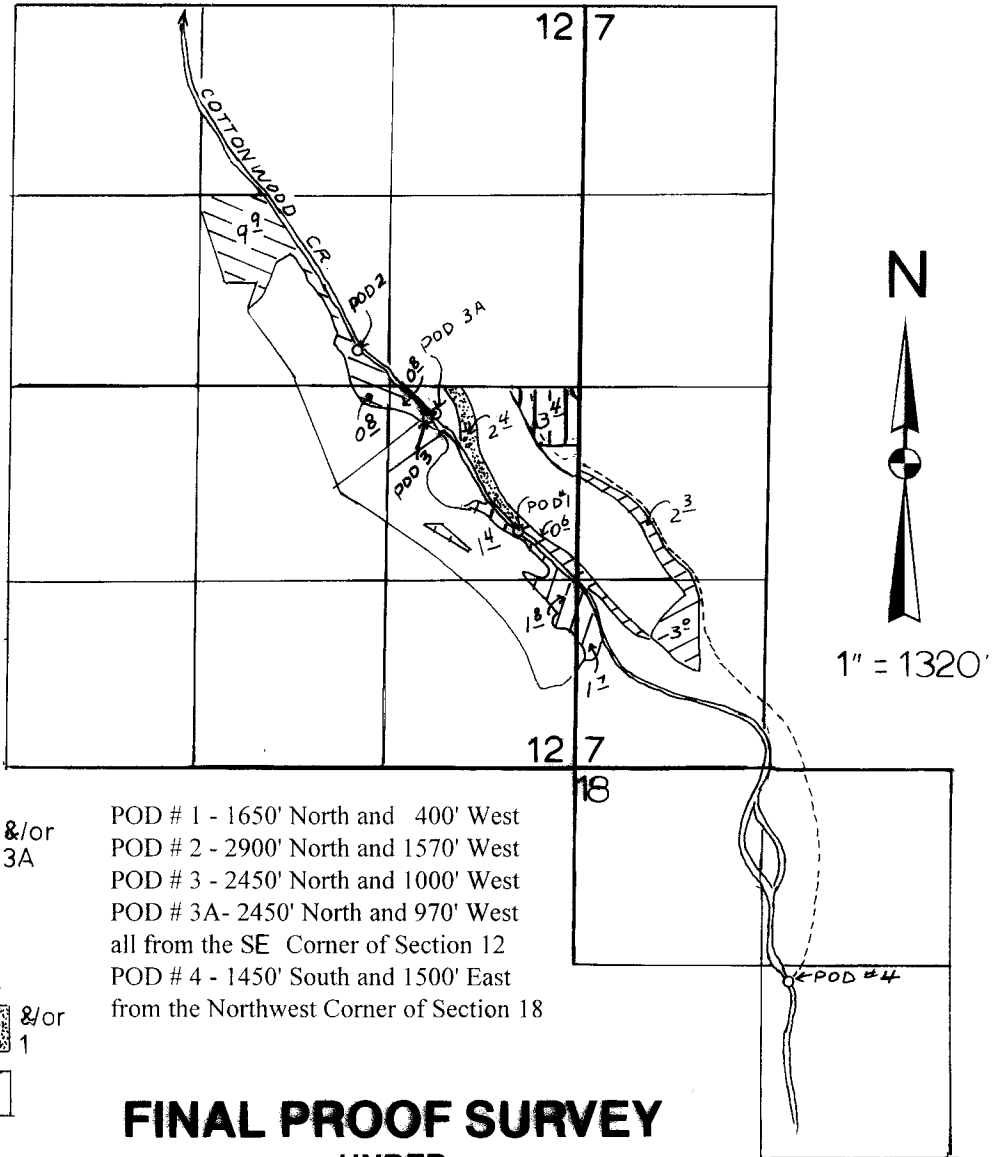
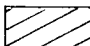

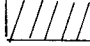
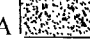



Township 9 S., Range 27 & 28 E., W.M.



- POD 1  &/or 3A
- POD 2 
- POD 3 
- POD 3A  &/or 1
- POD 4 

POD # 1 - 1650' North and 400' West
 POD # 2 - 2900' North and 1570' West
 POD # 3 - 2450' North and 1000' West
 POD # 3A- 2450' North and 970' West
 all from the SE Corner of Section 12
 POD # 4 - 1450' South and 1500' East
 from the Northwest Corner of Section 18

FINAL PROOF SURVEY UNDER

Application No.58866... Permit No.44380.....

IN NAME OF

RODNEY POTTER

SurveyedNOV. 1... 19...99... by ...J. Miller.....