

RECEIVED

FEB - 7 1994

WATER RESOURCES DEPT.
SALEM, OREGON

LEGEND

● EXISTING WELL

— 2" PVC

WELL #1 IS 57' SOUTH AND 165'
EAST OF THE CS 1/16 CORNER


WELL #2 IS 772' SOUTH AND 353'
EAST OF THE CS 1/16 CORNER

WELL #3 IS 127' SOUTH AND 165'
EAST OF THE CS 1/16 CORNER

WELL #4 IS 169' SOUTH AND 1700'
EAST OF THE CS 1/16 CORNER



CENTER
SOUTH 1/16 CORNER,
SECTION 3, T.13S.,
R.19E.

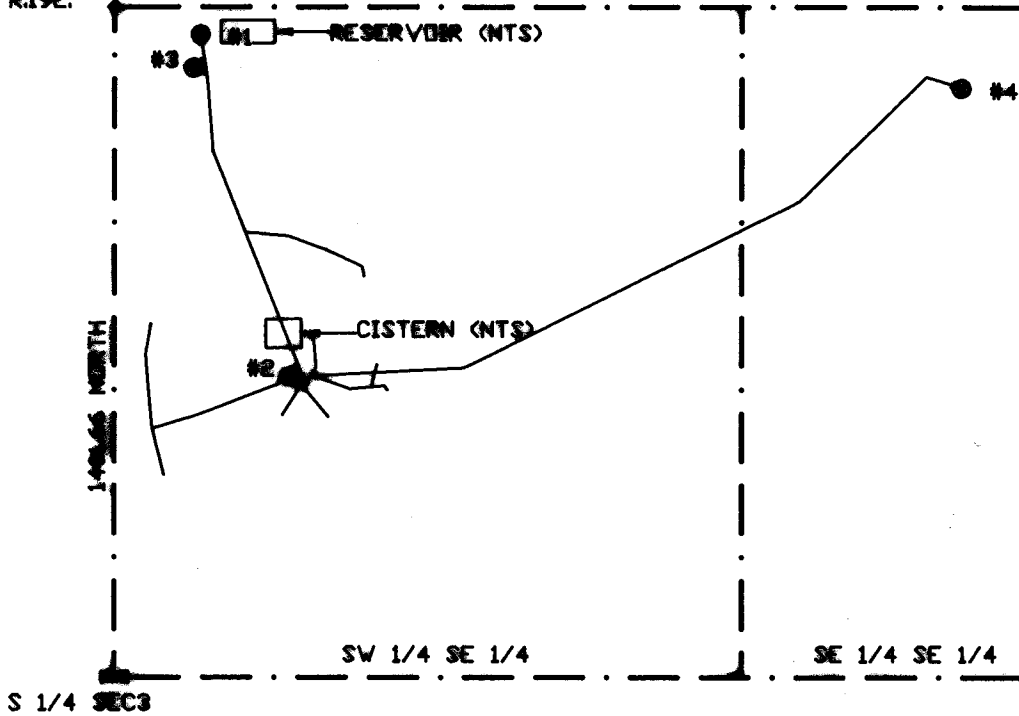

SECS, T13S, R19E, WML CREEK COUNTY, OREGON



Note: The preparation of this map was for the purpose of identifying the location of the proposed water right and has no intent to provide dimensions or locations of property ownership lines.

DESIGNED BY: PAM	CHECKED BY: DM	FINAL PROOF MAP MT. BACHELOR ACADEMY PERMIT NO. G-11906	DATE: 1/84	FIGURE: 1
DRAWN BY: REH	SCALE: 1"=400'		CENTURY WEST	
PROJECT NO.: 10888.004.01				