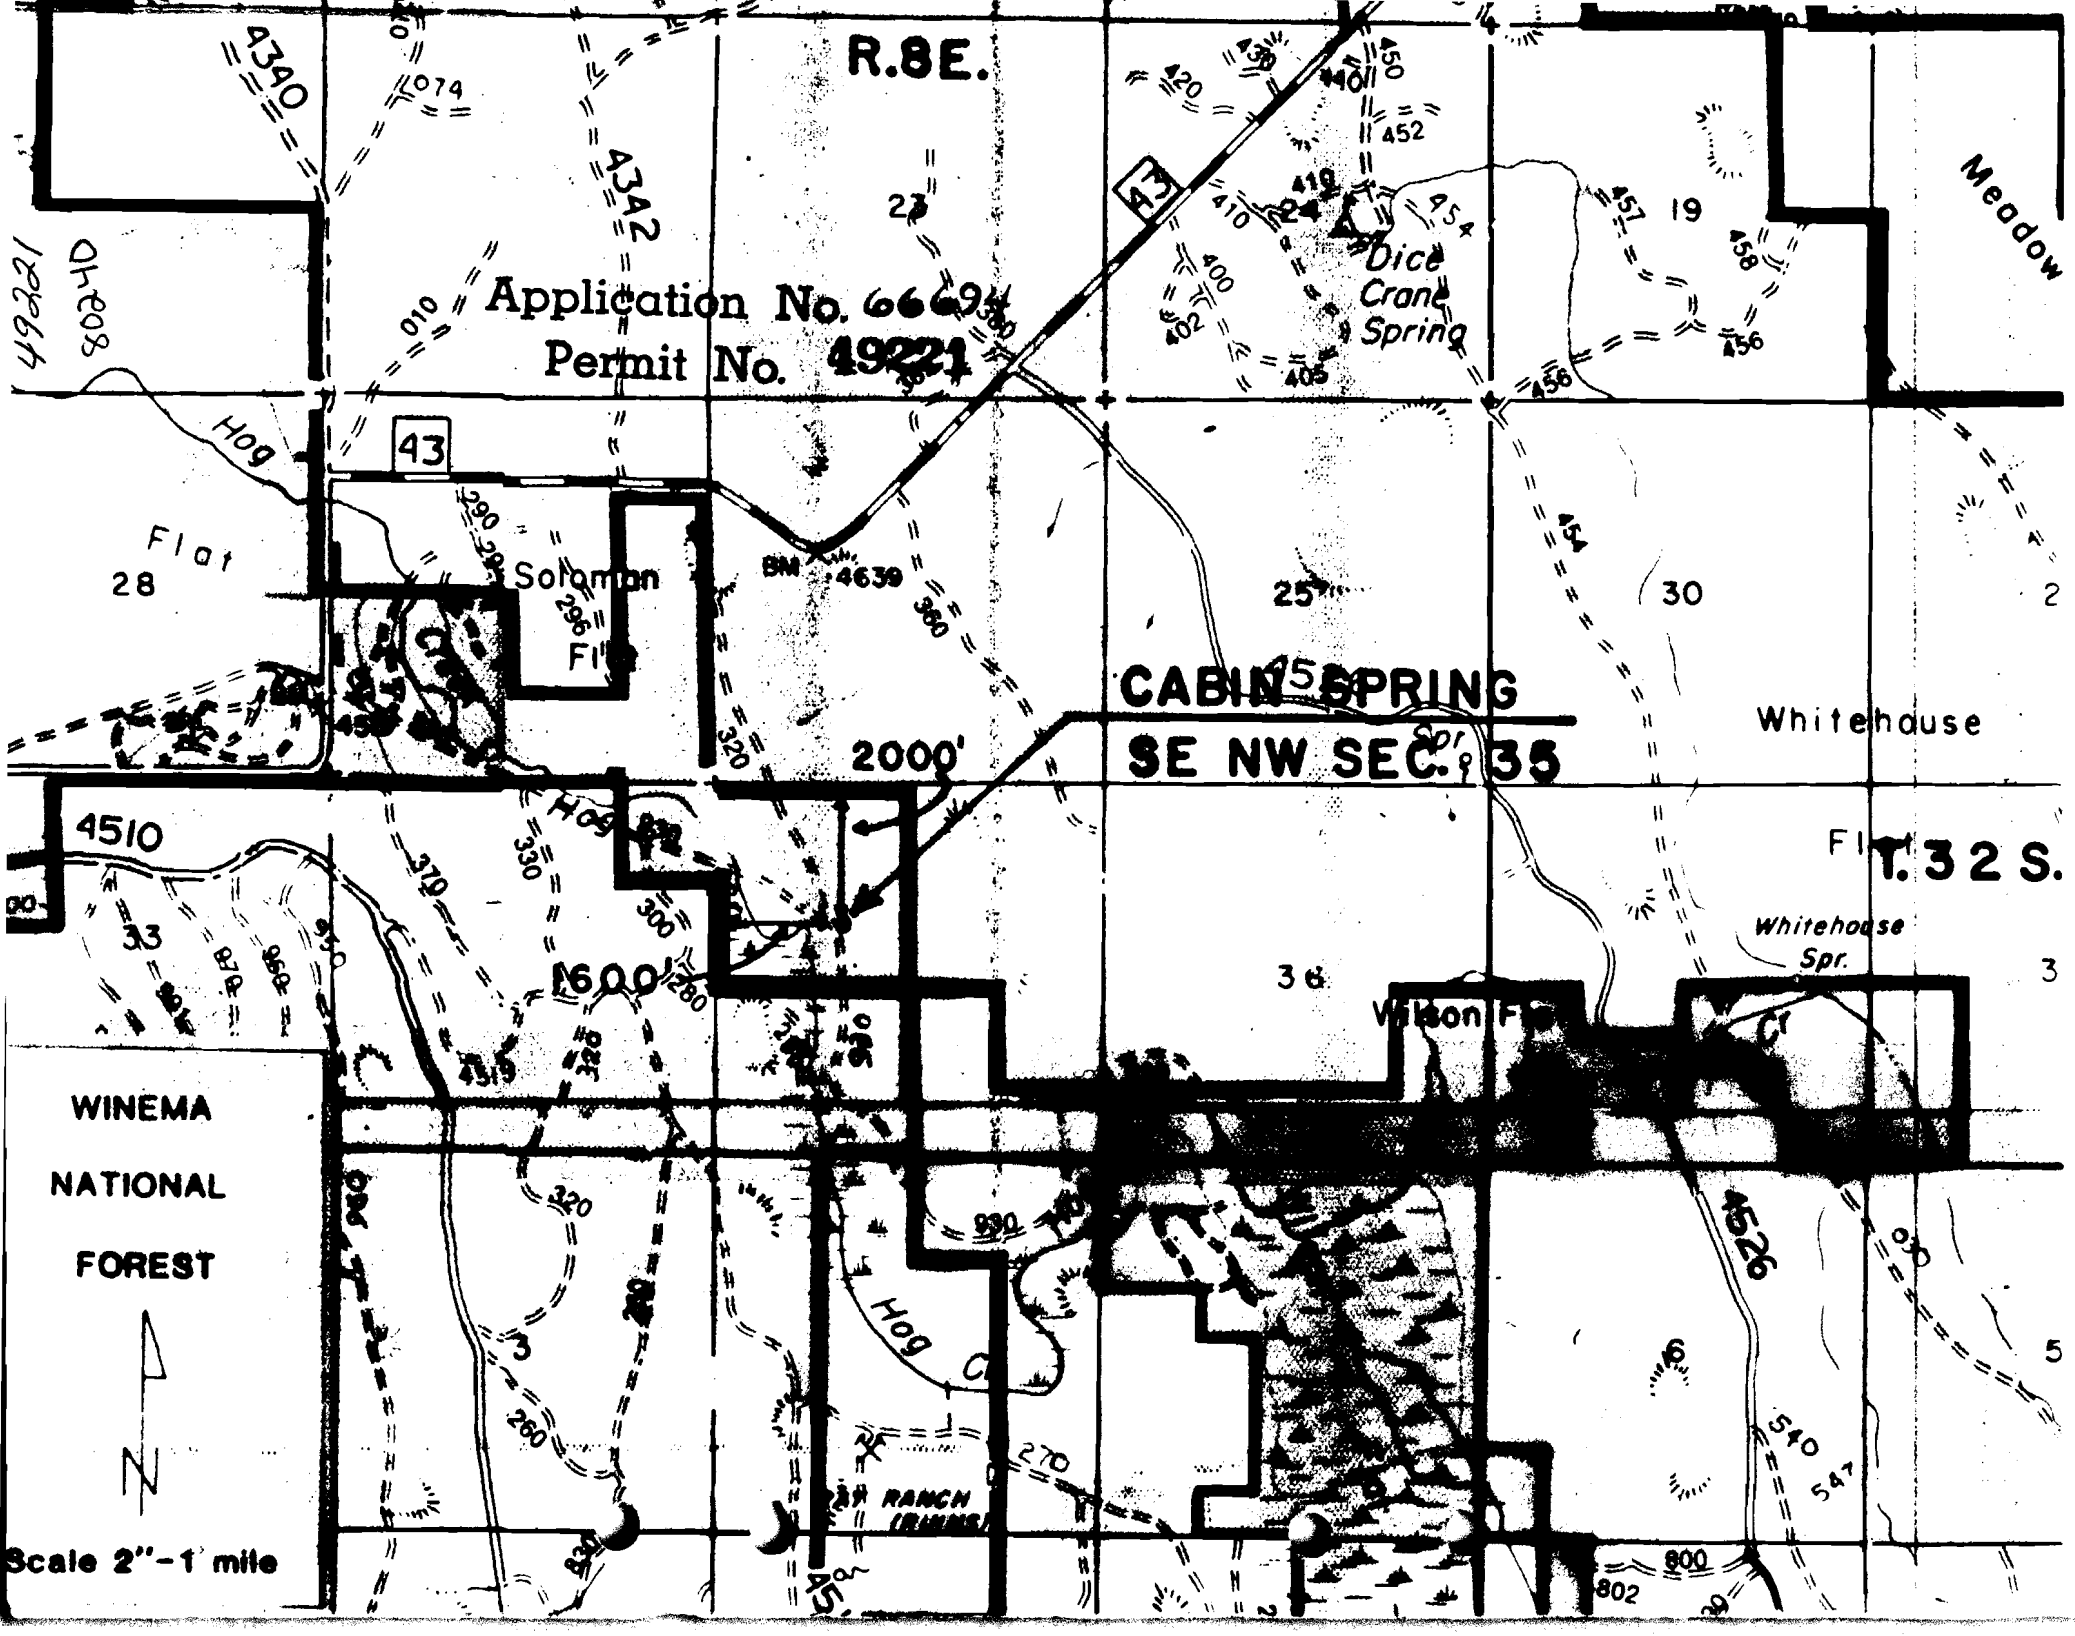

R.8E.
Application No. 66694
Permit No. 49221
Dice Crane Spring
Meadow
Hog Flat
Solomon Flat
BM 4639
CABIN SPRING
SE NW SEC. 35
2000'
1600'
Whitehouse
Whitehouse Spr.
Wilson Flat
T. 32 S.
WINEMA NATIONAL FOREST
Scale 2"-1 mile