


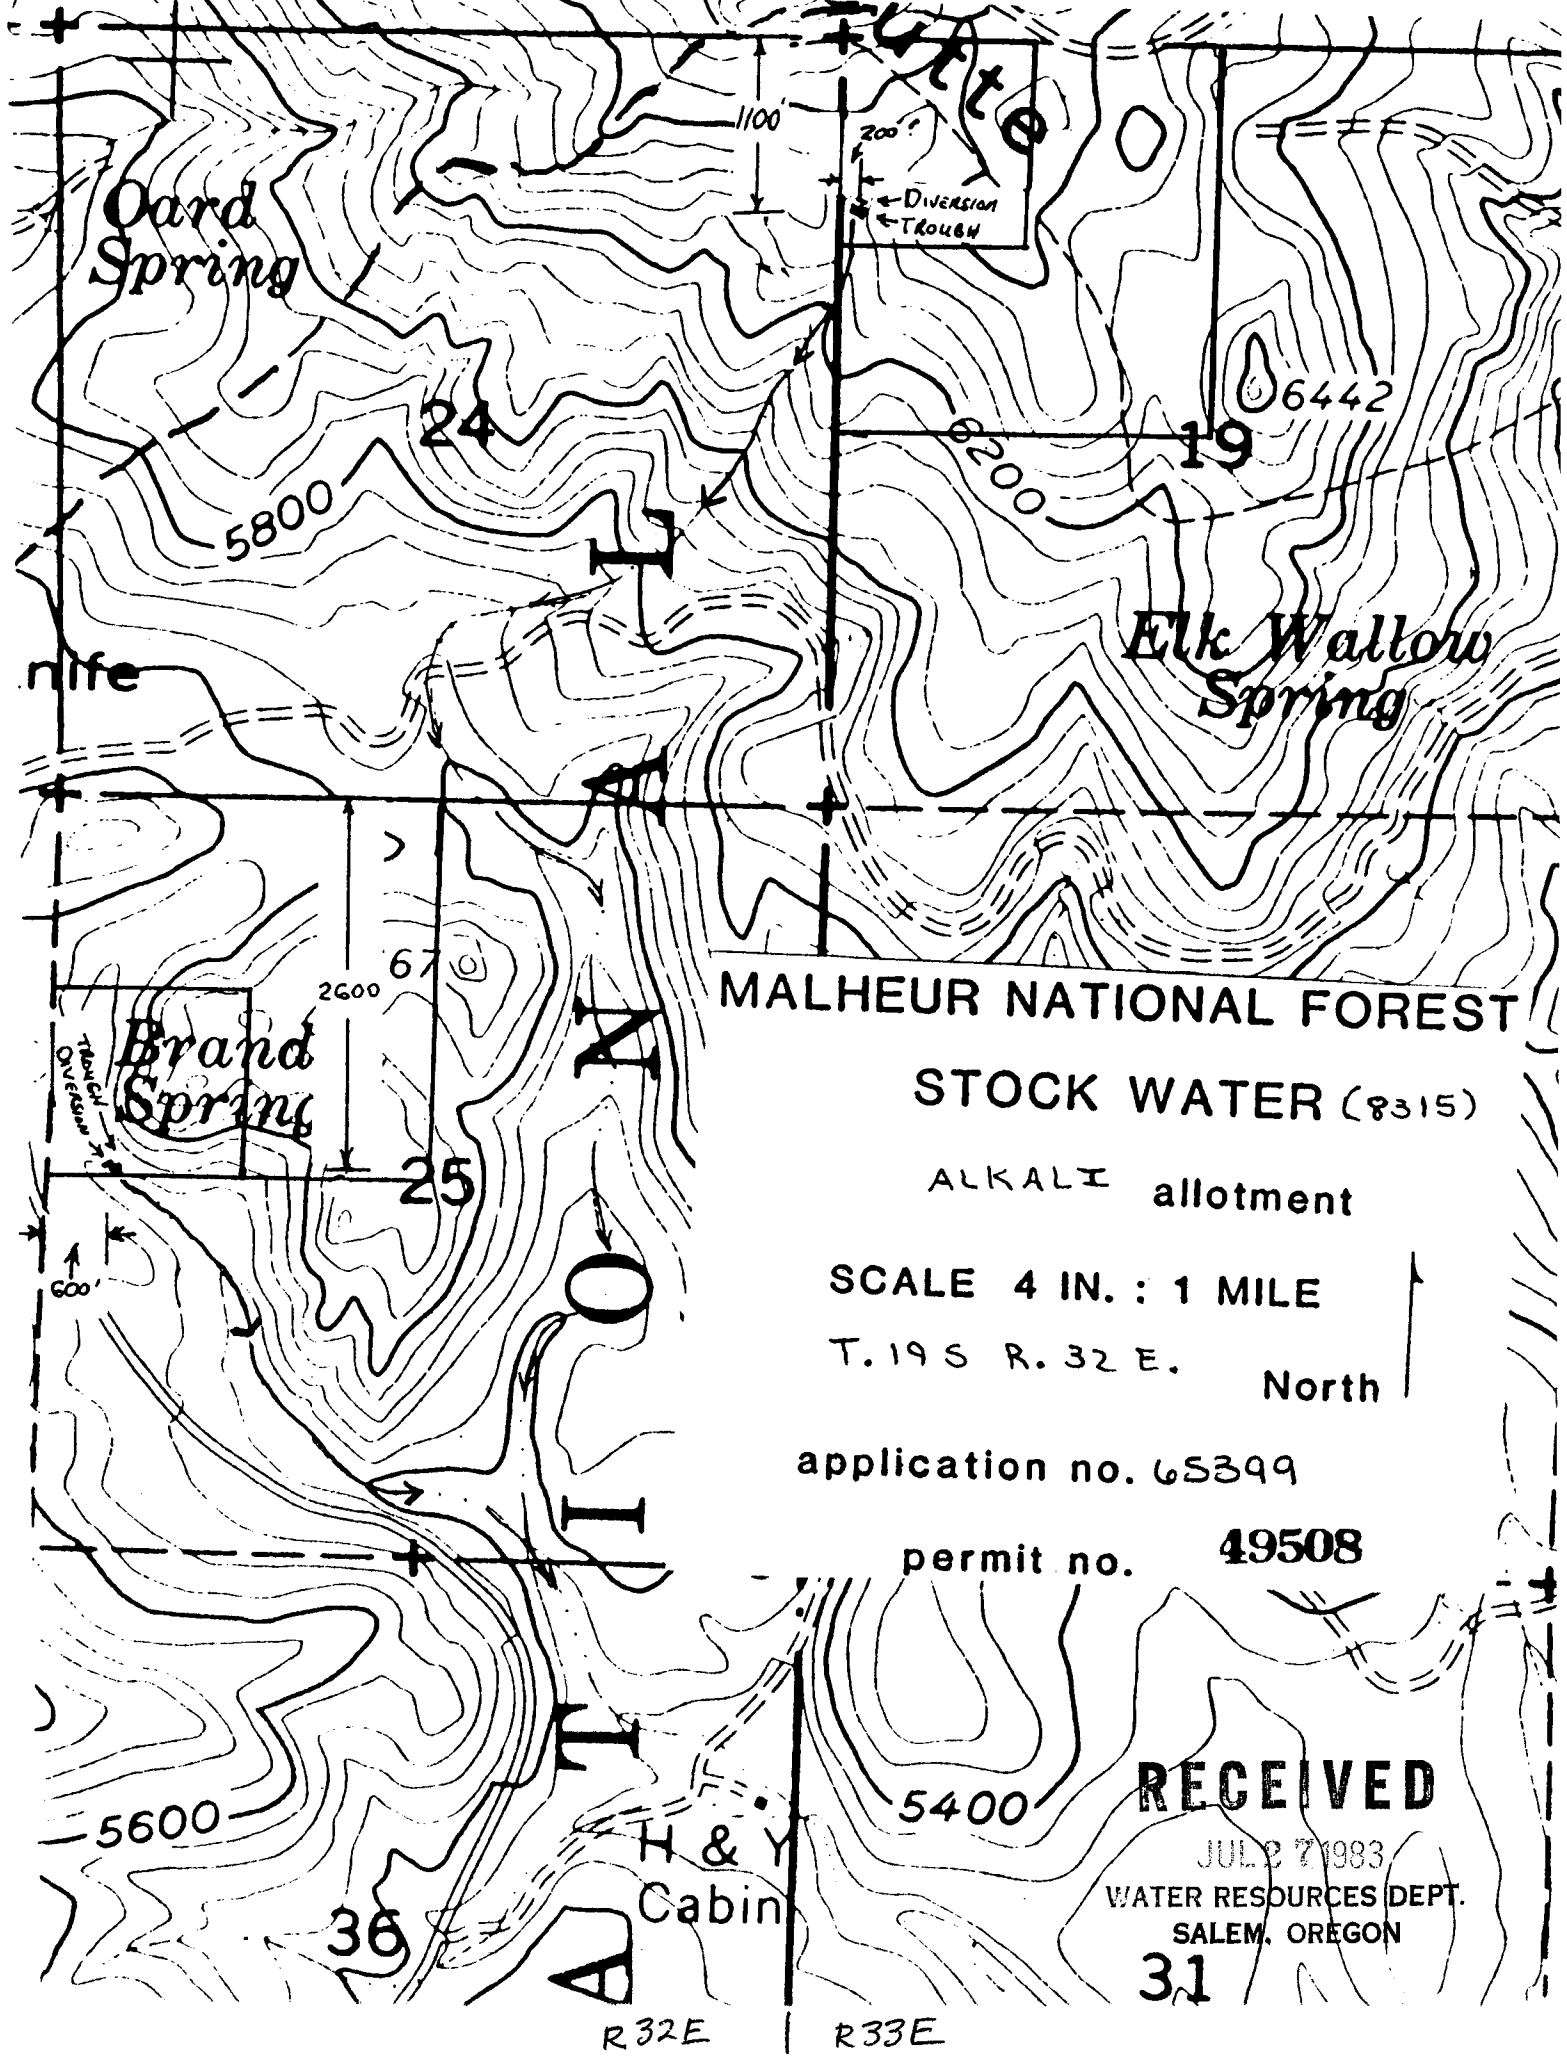

MALHEUR NATIONAL FOREST

STOCK WATER (8315)

ALKALI allotment

SCALE 4 IN. : 1 MILE

T. 19 S R. 32 E. North

application no. 65399

permit no. 49508

RECEIVED

JUL 27 1983
WATER RESOURCES DEPT.
SALEM, OREGON

31

R32E R33E