


RECEIVED
WATER RESOURCES DEPT.
SALEM, OREGON

T10 S R37E W.M.

Section 22

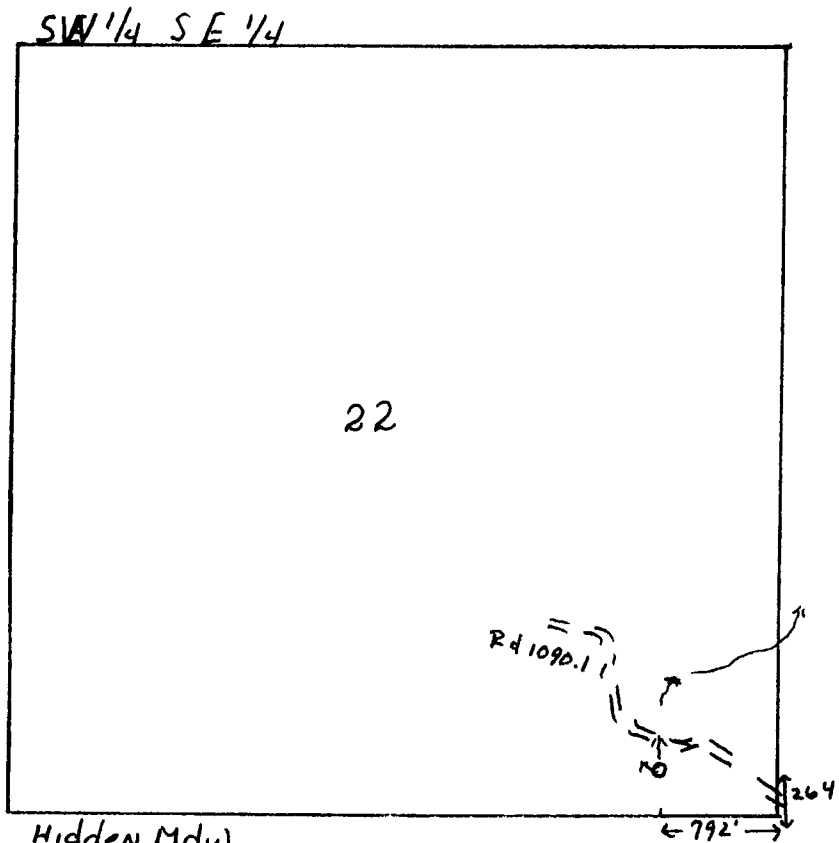

Scale 4" = 1 mile

RECEIVED

AUG 29 1983

WATER RESOURCES DEPT
SALEM, OREGON

Application No. 65734

Permit No. 50630