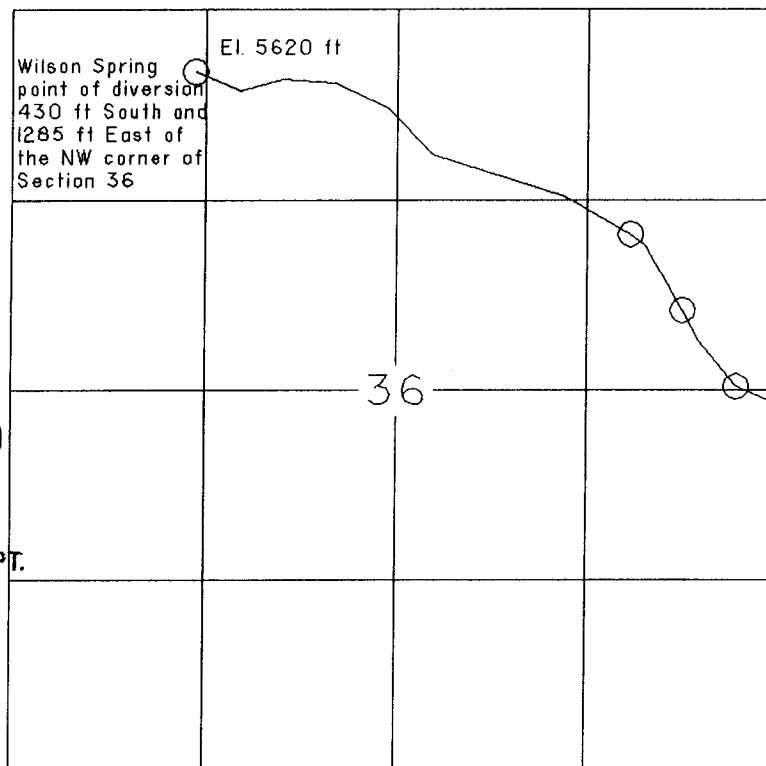



T. 37 S., R. 29 E., W.M.

ORIGINAL
STONE**RECEIVED**

DEC - 1 1997

WATER RESOURCES DEPT.
SALEM, OREGON

1" = 1320'

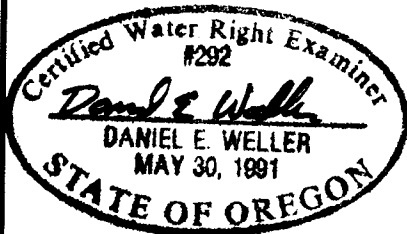

FINAL PROOF MAP

UNDER

APPLICATION NO. 70053

PERMIT NO. 50840

IN NAME OF

UNITED STATES BUREAU OF LAND MANAGEMENT


SURVEYED: SEPTEMBER 23, 1997

——— PVC PIPELINE, 1 IN. DIAMETER


○ CORRUGATED METAL PIPE, 24 INS. DIAM., WITH SHUTOFF VALVE

THE PURPOSE OF THIS MAP IS FOR IDENTIFYING THE LOCATION OF THE WATER RIGHT ONLY AND
IS NOT INTENDED TO PROVIDE LEGAL DIMENSIONS OR LOCATION OF PROPERTY OWNERSHIP LINES.THE TIE WAS DETERMINED BY INVERSE BETWEEN POSITIONS, DERIVED FROM A RESOURCE GRADE GLOBE POSITIONING
SYSTEM, A ROCKWELL PLGR, WITH A POSITIONAL ACCURACY OF 2-5 METERS, 50 PERCENT OF THE TIME.U.S. BUREAU OF LAND MANAGEMENT-OSO
BRANCH OF CADASTRAL SURVEY
LETTER OF AUTHORIZATION
DATED: AUGUST 29, 1997EXECUTED BY:
DANIEL E. WELLER, PLS, CWRE
P.O. BOX 2965
PORTLAND, OREGON 97208

T. 37 S., R. 30 E., W.M.

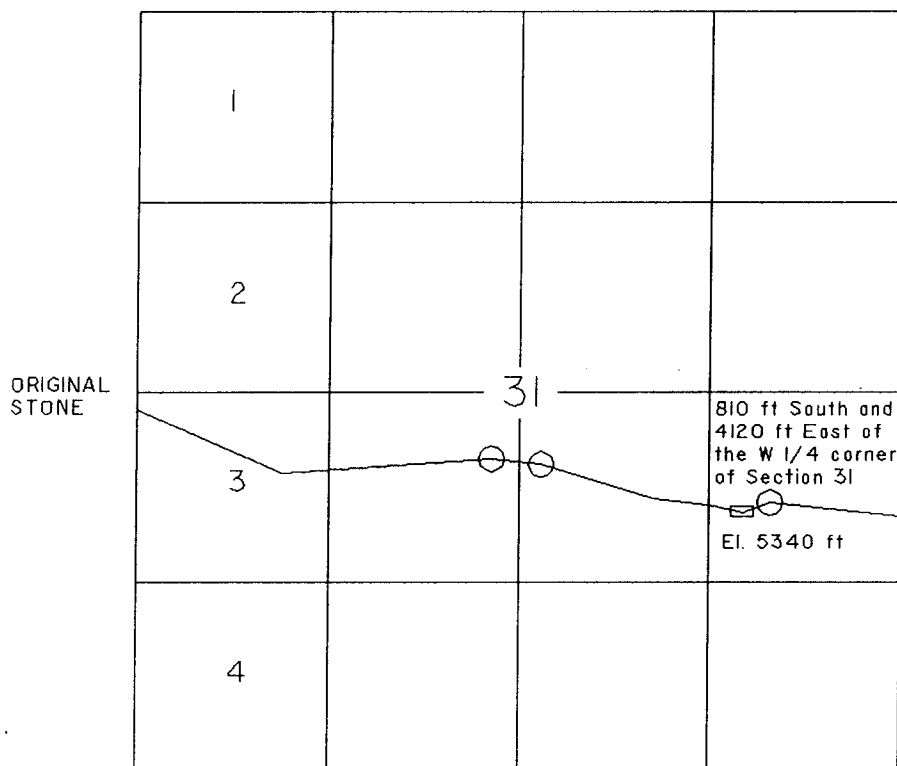

1" = 1320'

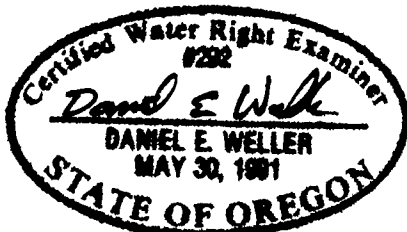

FINAL PROOF MAP

RECEIVED

DEC - 1 1997

WATER RESOURCES DEPT.
SALEM, OREGON

UNDER

APPLICATION NO. 70053

PERMIT NO. 50840

IN NAME OF

UNITED STATES BUREAU OF LAND MANAGEMENT

SURVEYED: SEPTEMBER 23, 1997

- _____ PVC PIPELINE, 1 IN. DIAMETER □ TROUGH AT PLACE OF USE, 1.5 GPM
 ○ CORRUGATED METAL PIPE, 24 INS. DIAM., WITH SHUTOFF VALVE


THE PURPOSE OF THIS MAP IS FOR IDENTIFYING THE LOCATION OF THE WATER RIGHT ONLY AND IS NOT INTENDED TO PROVIDE LEGAL DIMENSIONS OR LOCATION OF PROPERTY OWNERSHIP LINES.

THE TIE WAS DETERMINED BY INVERSE BETWEEN POSITIONS, DERIVED FROM A RESOURCE GRADE GLOBE POSITIONING SYSTEM, A ROCKWELL PLGR, WITH A POSITIONAL ACCURACY OF 2-5 METERS, 50 PERCENT OF THE TIME.

U.S. BUREAU OF LAND MANAGEMENT-OSO
BRANCH OF CADASTRAL SURVEY
LETTER OF AUTHORIZATION
DATED: AUGUST 29, 1997

EXECUTED BY:
DANIEL E. WELLER, PLS, CWRE
P.O. BOX 2965
PORTLAND, OREGON 97208

T. 37 S., R. 30 E., W.M.

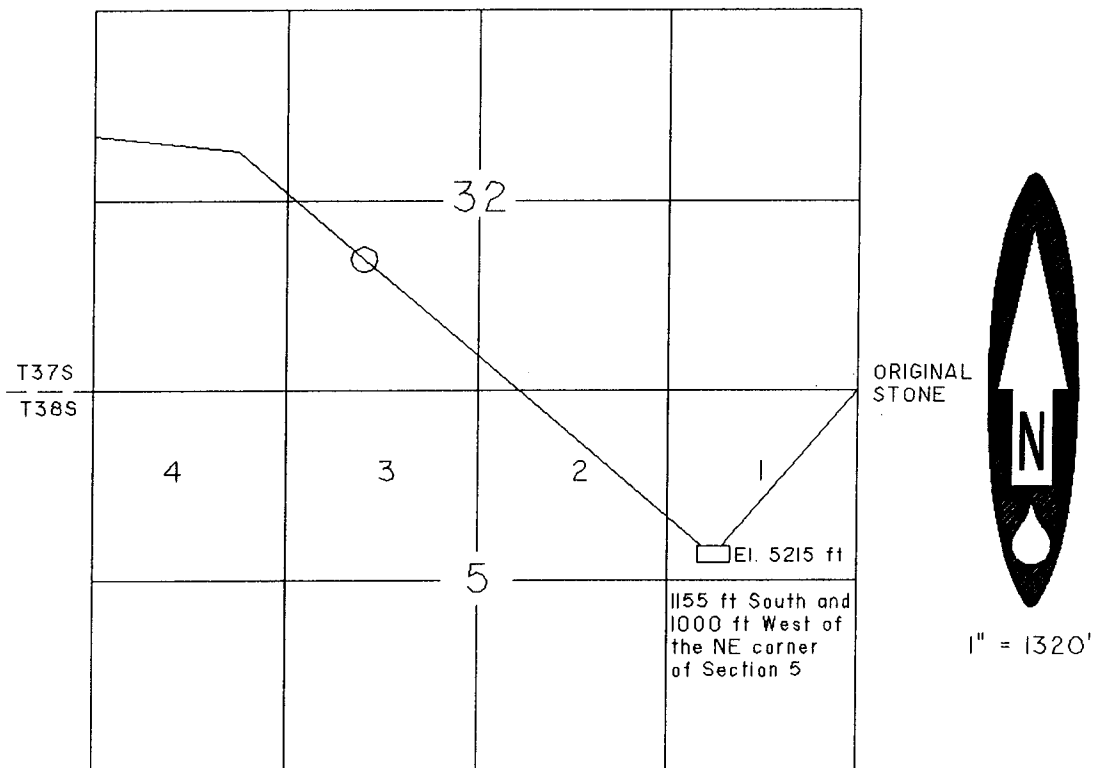

FINAL PROOF MAP

RECEIVED

DEC - 1 1997

WATER RESOURCES DEPT.
SALEM, OREGON

UNDER

APPLICATION NO. 70053 PERMIT NO. 50840

IN NAME OF

UNITED STATES BUREAU OF LAND MANAGEMENT

SURVEYED: SEPTEMBER 23, 1997

- PVC PIPELINE, 1 IN. DIAMETER □ TROUGH AT PLACE OF USE, 1.5 GPM
- CORRUGATED METAL PIPE, 24 INS. DIAM., WITH SHUTOFF VALVE

THE PURPOSE OF THIS MAP IS FOR IDENTIFYING THE LOCATION OF THE WATER RIGHT ONLY AND
IS NOT INTENDED TO PROVIDE LEGAL DIMENSIONS OR LOCATION OF PROPERTY OWNERSHIP LINES.

THE TIE WAS DETERMINED BY INVERSE BETWEEN POSITIONS, DERIVED FROM A RESOURCE GRADE GLOBE POSITIONING
SYSTEM, A ROCKWELL PLGR, WITH A POSITIONAL ACCURACY OF 2-5 METERS, 50 PERCENT OF THE TIME.

U.S. BUREAU OF LAND MANAGEMENT-OSO
BRANCH OF CADASTRAL SURVEY
LETTER OF AUTHORIZATION
DATED: AUGUST 29, 1997

EXECUTED BY:
DANIEL E. WELLER, PLS, CWRE
P.O. BOX 2965
PORTLAND, OREGON 97208

