

SCALE
4" = 1 mile
NORTH ↑

Cottonwood Spring
T 11 S., R. 14 E.
Sec. 23. SW, SE.


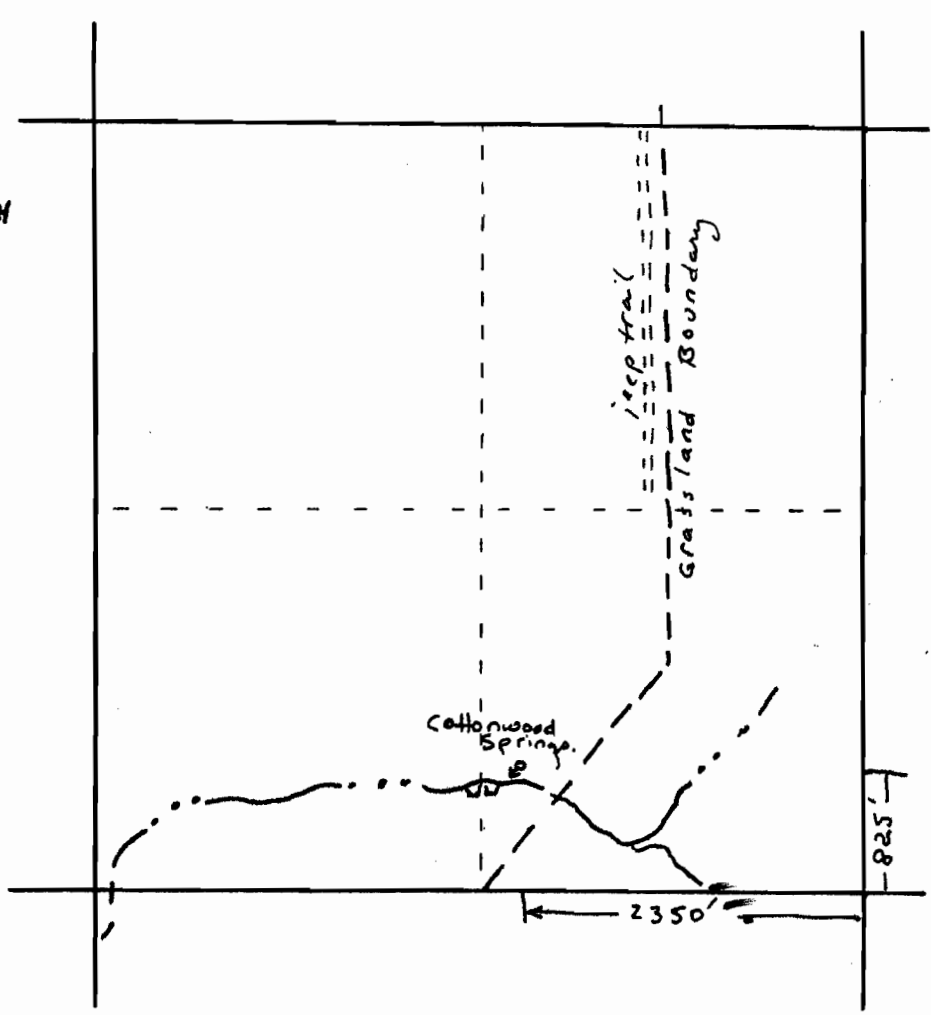


Diagram of Development ↑ N
1" = 100'

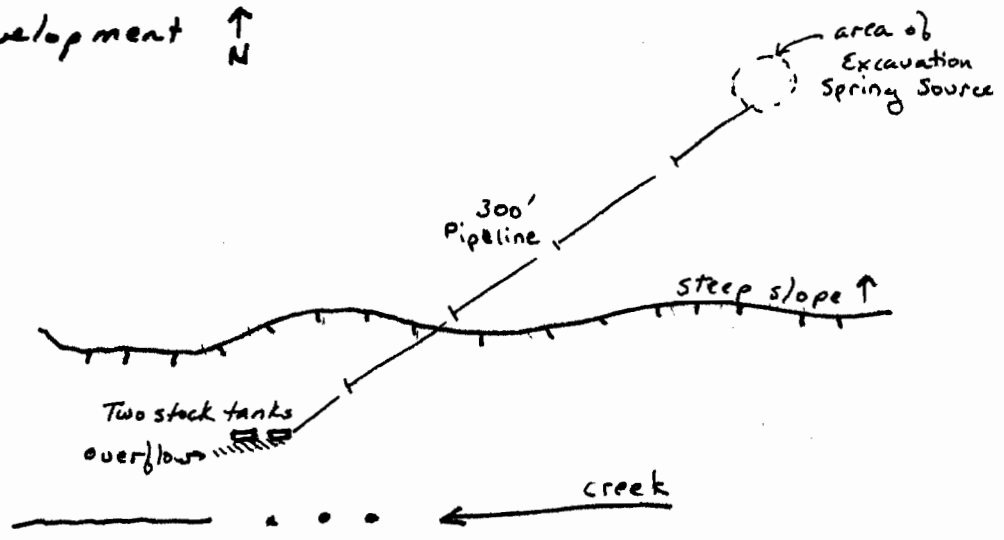

Application No. 66367
Permit No. 52363